

Rd #101-A


Report of Viewers. Field notes and plat of survey of a ^{change in a} County Road on the land of D. W. Bailey, leading from Pendleton to Cold Spring.

To the Hon. County Court for Umatilla County, Oregon.

We the undersigned having been appointed by your Hon. body to view out and survey a change in a County Road leading from Pendleton to Cold Spring in the above named County and State and through the land of D. W. Bailey would respectfully report that we met at the time and place appointed, and after being qualified by A. L. Coffey County Surveyor according to law, we proceeded to view out and survey said change to-wit: commencing in the County Road at the S. W. corner of the N. E. 1/4 of Sec 27 T. 3. N. R. 32 E. of W. W. from which we run East to the County Road on the line between Secs 26 & 27 T. 3. N. R. 32 E. said Road running South to the Town of Pendleton.

We further report the change is as good and practical road as the old Road and does not materially change the distance of said Road and we would recommend that the change be granted. This the 8th day of Sept 1883.

D. K. Smith
J. H. Turner
Viewers of said proposed road

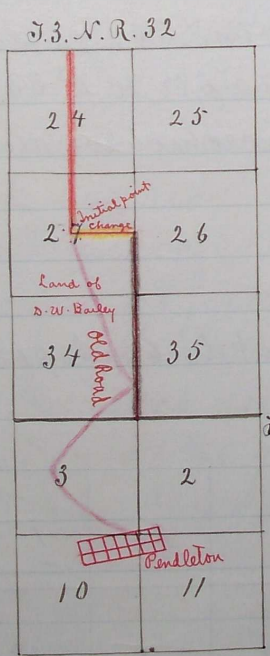

Journal F. page 125
.. F .. 130.

I hereby certify that the above plat is a true and correct plat and survey of said Road
Recorded Sept 15th 1883

A. L. Coffey
County Surveyor for Umatilla Co Or

J. P. Bushee Clerk