


G 213

Township 5. North. Range 34 East

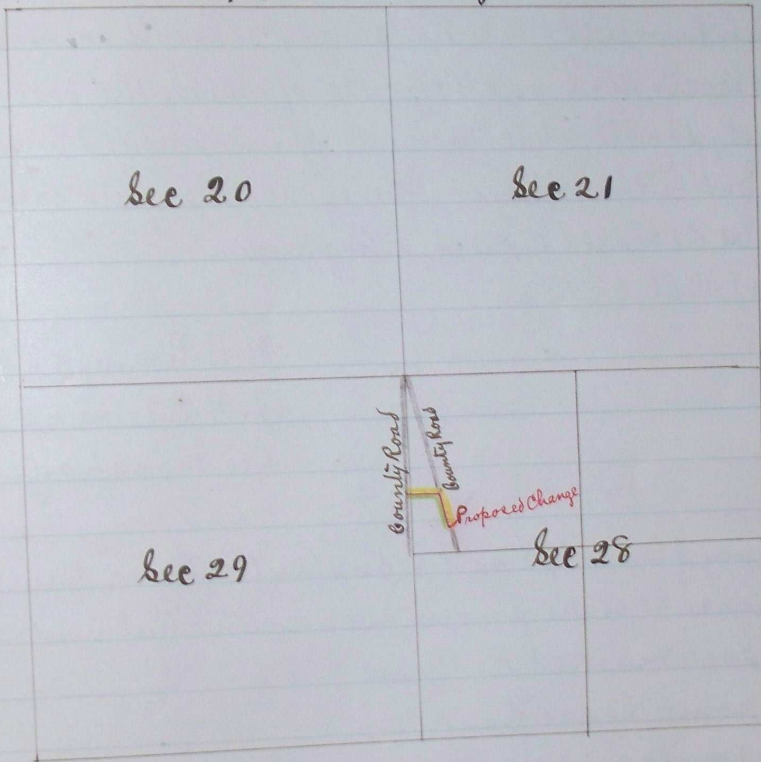

Plat of proposed change of Gerking Flat Road by
 W. W. Caviness
 Surveyor

Journal F page 149

" F " 240

Recorded Feby 8th 1884

J. P. Bushie
Clerk.