


Map of County Road surveys from (A) at South abutment of bridge over Umatilla River at mouth of Butter Creek to (B) Foster, Oregon. all in Umatilla County.

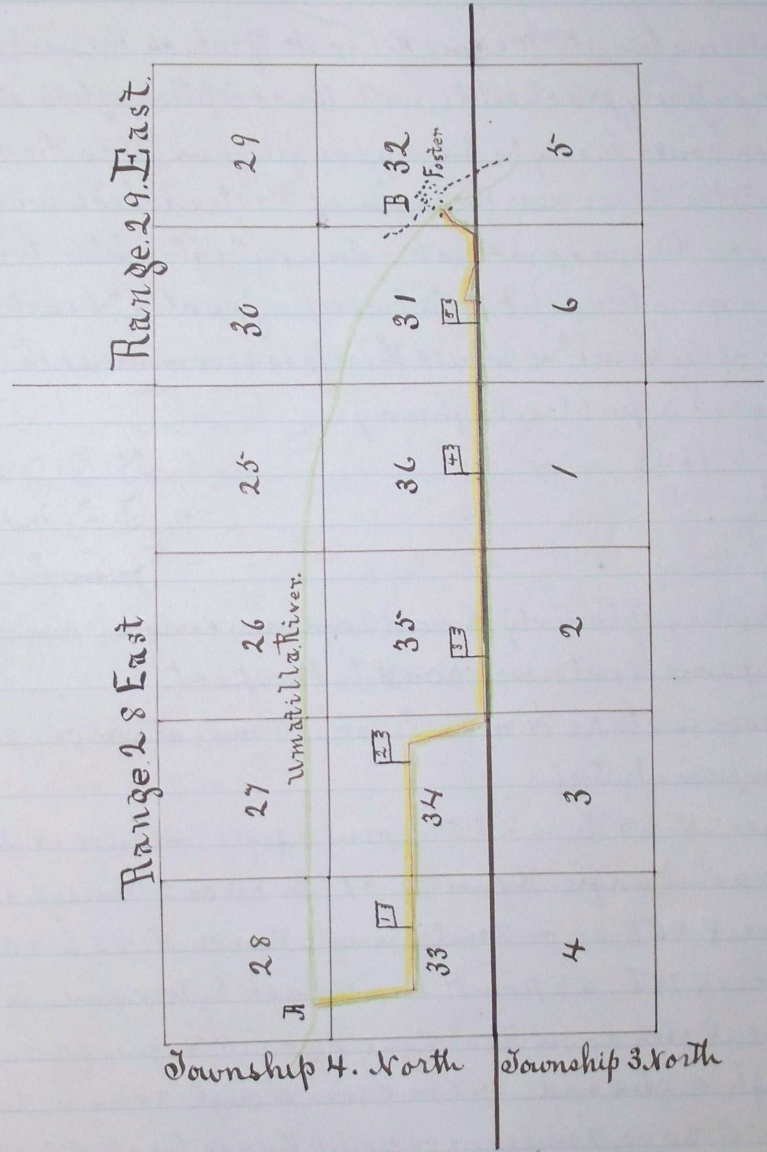

Journal F page 118  
" F " 237  
Recorded Feby 9<sup>th</sup> 1884

J.P. Bushue Clerk.