


Road No 172.

Map of County Road surveyed from A situated on County Road running from Ranch of O. F. Thompsons on Butter Creek to each between 5<sup>th</sup> & 6<sup>th</sup> mile posts. thence by Bat Foster to C. the point of termination on County road running from Umatilla via Prospect to Pendleton.

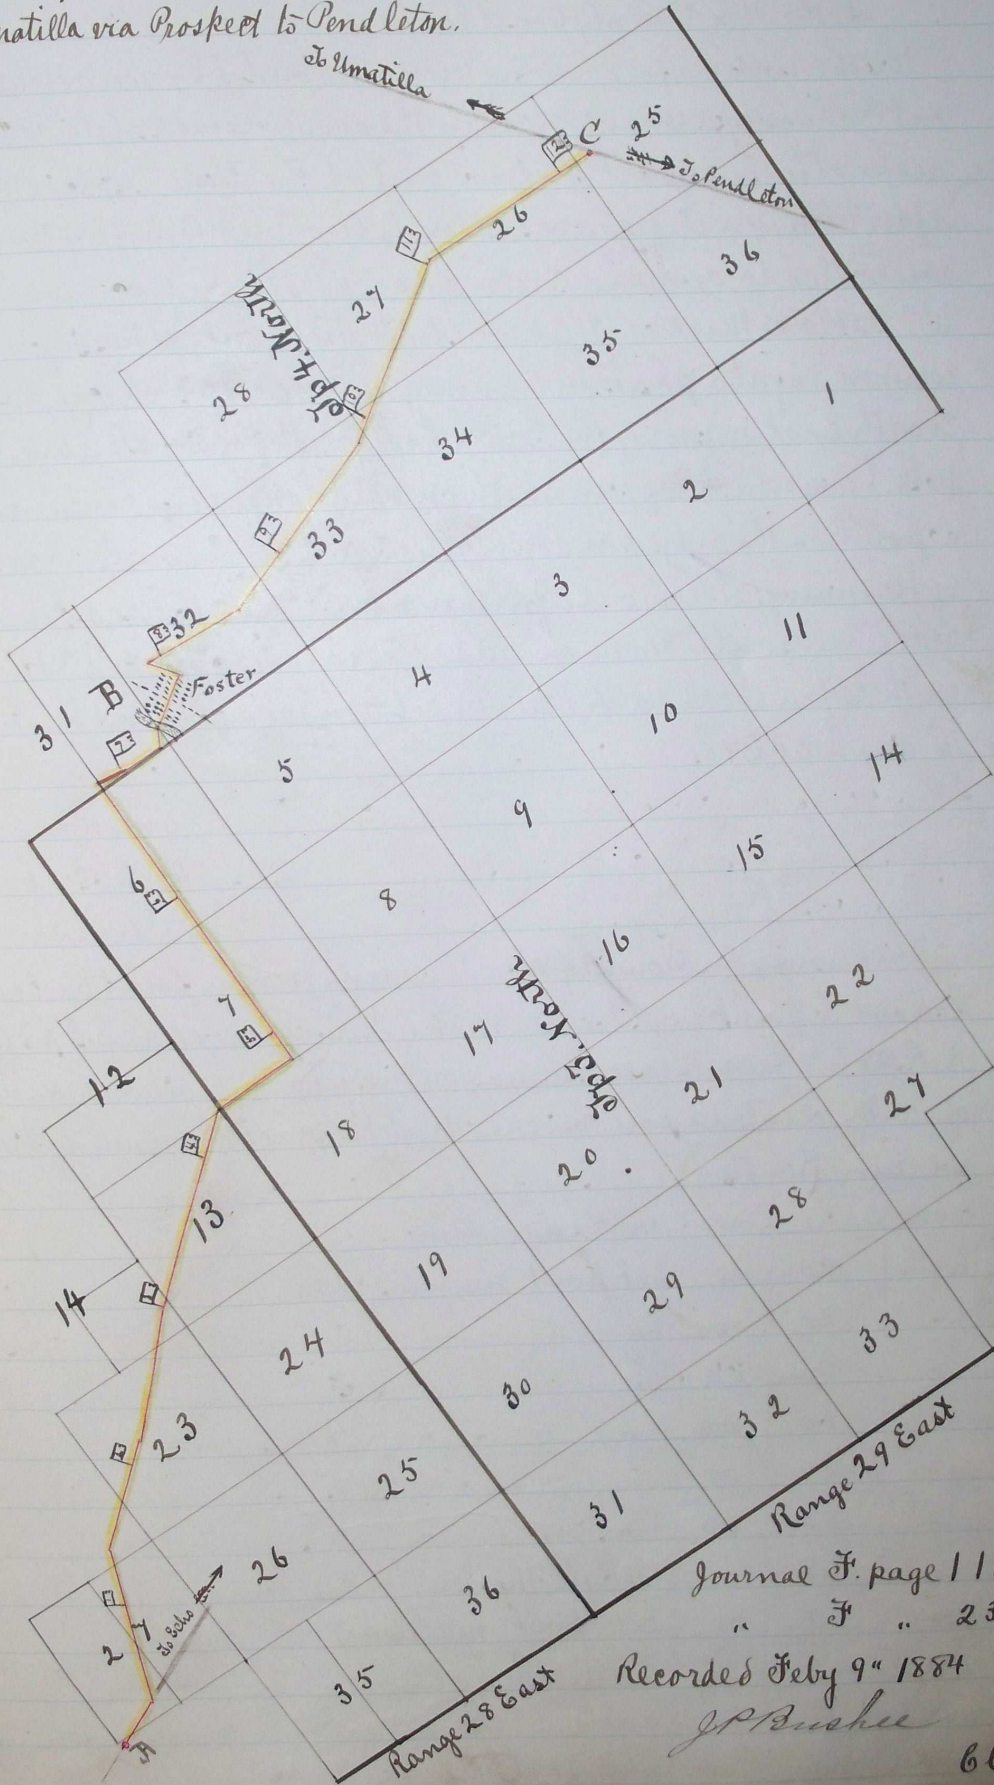

Journal F. page 116

" " " 237

Recorded Feby 9<sup>th</sup> 1884

J.P. Bushie

Clerk