



Pendleton to Gold Spring County Road,  
This the first day of Oct A. D. 1883,

W. W. Caviness, Surveyor.

Sp 5 N. R 32 E

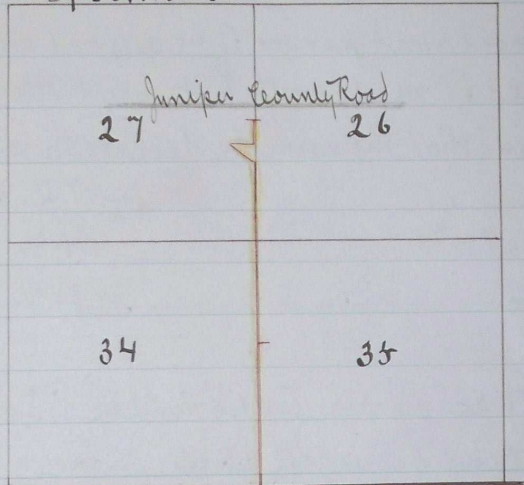

Sp 4 N. R 32 E.

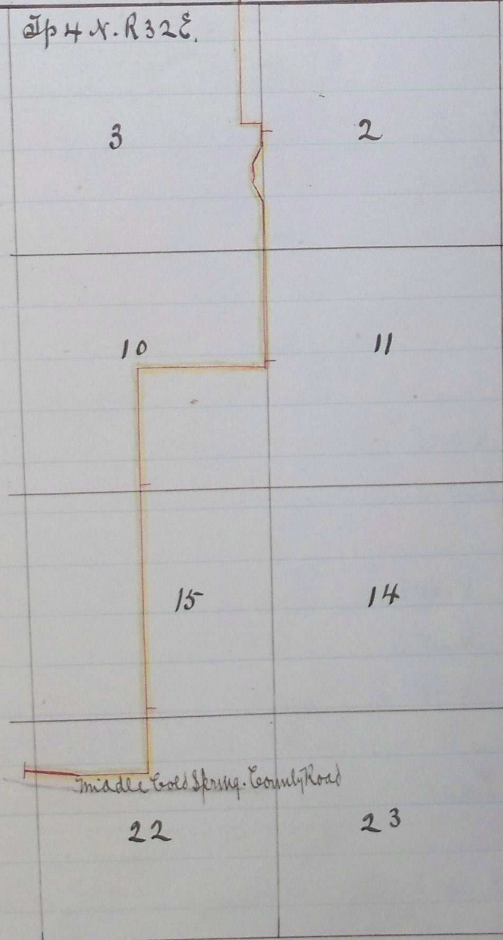

Journal F. pages 67-68

" F. " 238-

Recorded Feby 11<sup>th</sup> 1884

W. W. Caviness Clerk.