


14.00 Terminus Intersect Stage Canyon  
Survey Commenced Oct 8<sup>th</sup> Completed Oct 9<sup>th</sup> 1883.

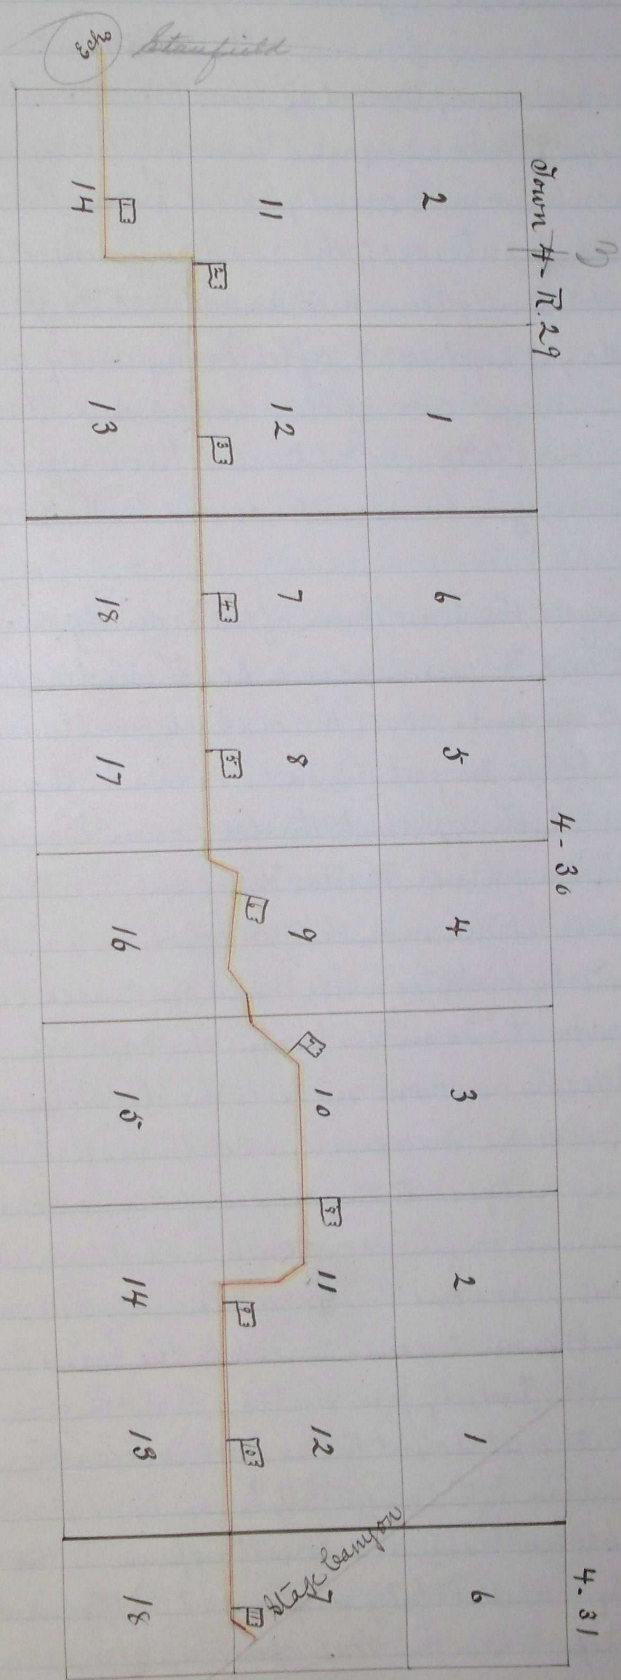

Journal T. Page 130  
 " 7. " 238  
 Recorded Feby 12<sup>th</sup> 1884  
 J. P. Anshel Clerk.