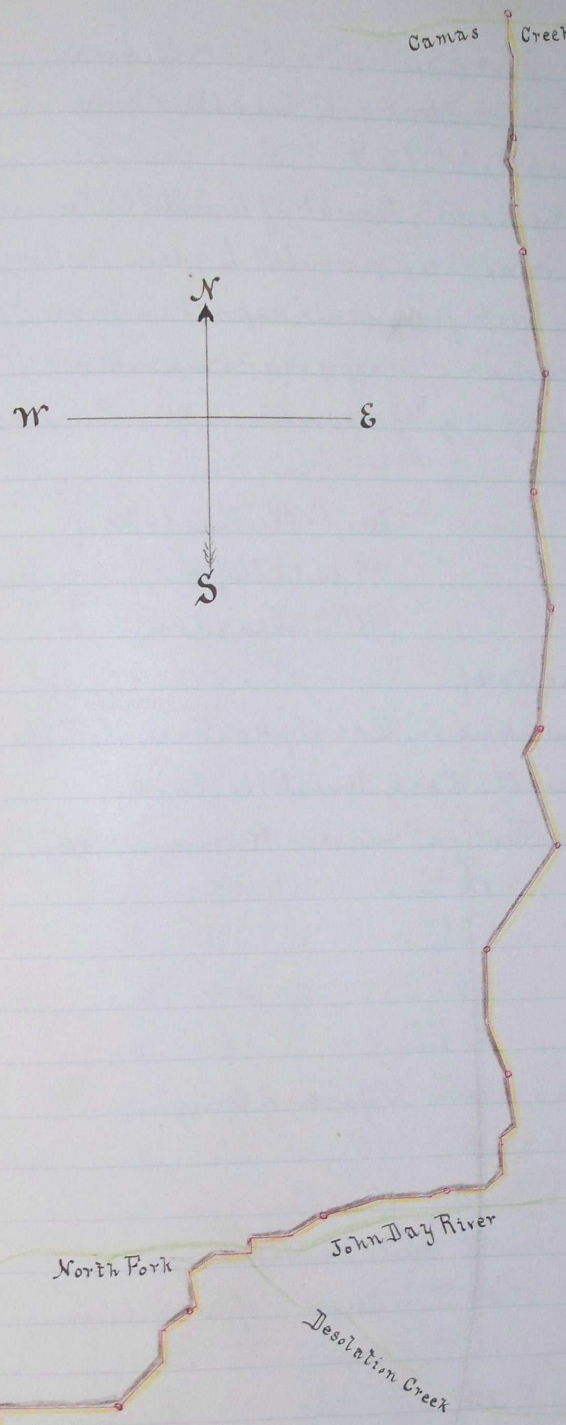

I hereby certify that This is a true Plat of road survey No 143 from Alba Cabin to the County line between Umatilla and Grant Counties.

This the 29" day of September 1883.

W. W. Caviness
Surveyor

Journal E. pages 630-631
" F " 44-45
" F " 239.

Recorded Feby 12" 1884

J. P. Bushee
Clerk