
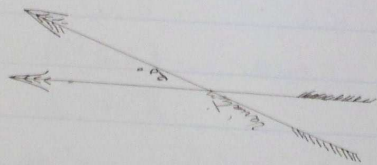


Plat of Road No 183.

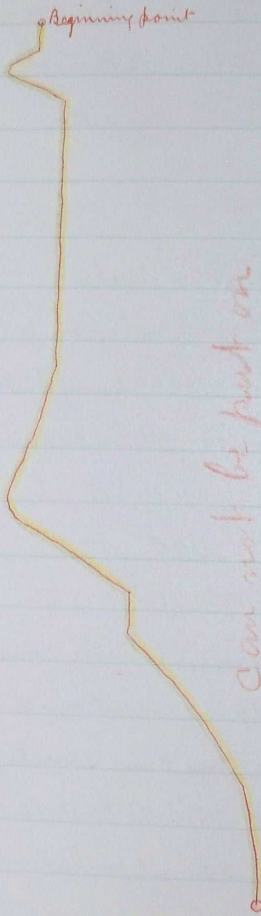

I hereby certify that the above plat and specifications are true and correct.

Julius Keithley
Surveyor

Journal F. page 261

" " " 316.

Recorded May 9th 1884

J.P. Bushee
Clerk

ROAD
178
...
...