


Plat of Road N^o 179.

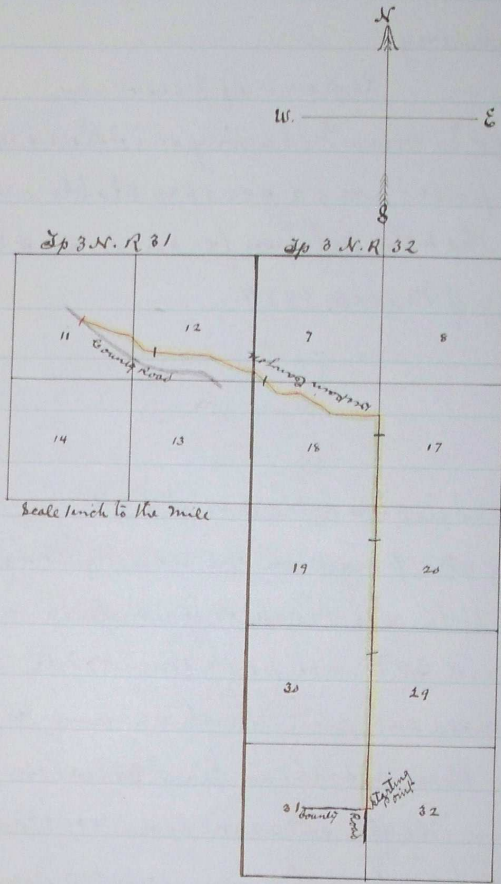

I hereby certify That this is a true Plat of Road Survey of Road N^o 179.

Surveyed March 13th 1884

W. W. Caviness
Surveyor

Journal F. page 256

" F. " 318

Recorded May 10th 1884

J. P. Bushie
Clerk.