


Plat of Road N^o 189.

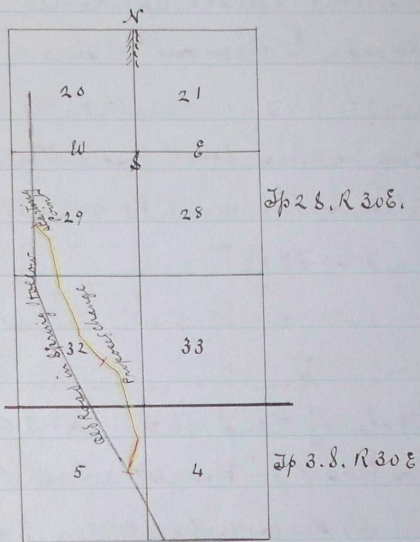

Scale 1 inch to the mile

I hereby certify this to be a true

Plat of Road Survey, N^o 189.

Surveyed June 5th 1884

By W. W. Caviness

Journal F. page 384

.. F .. 424

Recorded Aug 15th 1884

J. Bushee

Clerk.