Plat of Road No 205.

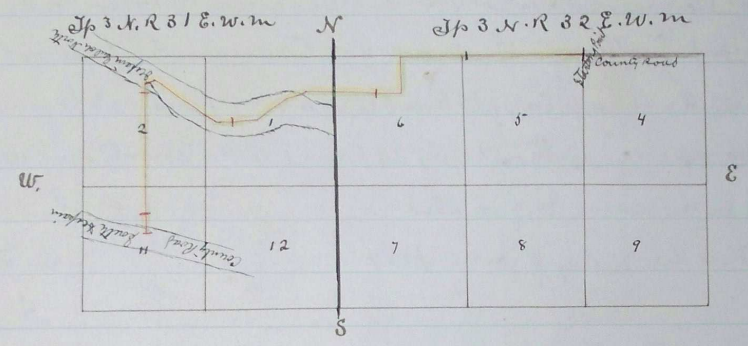

Journal "F" page 398
" "F" " 448
Recorded Aug 16" 1884
J P Bushee
Clerk

I hereby certify this to be a true Plat of Road Survey No 205 as described in accompanying Field Notes.
Surveyed May 13 & 14" 1884
By W. W. Cavines