


Plat of Road No 203.

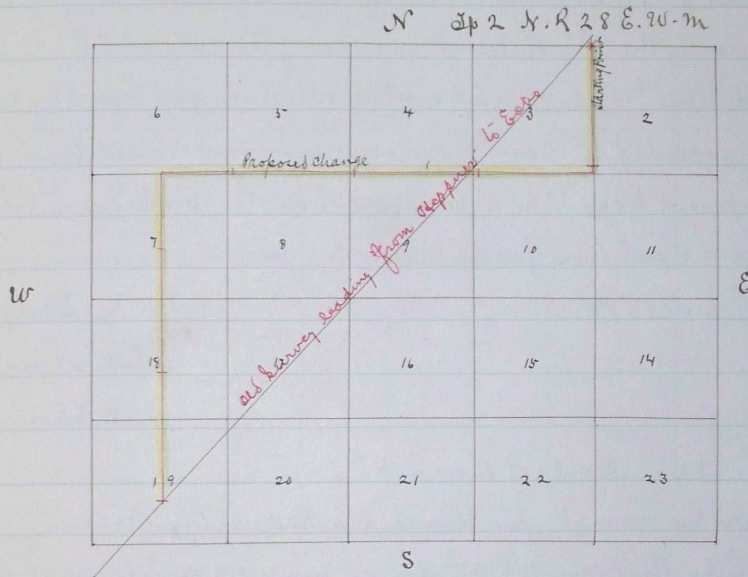

Scale 1 Inch to the mile.

I hereby certify that this is a true Plat of Road

Journal "F" page 400

Survey No 203.

" " " " 448

Surveyed June 7th 1884

Recorded Aug 16th 1884

By W. W. Caviness,

J. P. Bushee

Clerk.