Plat of Road № 200.

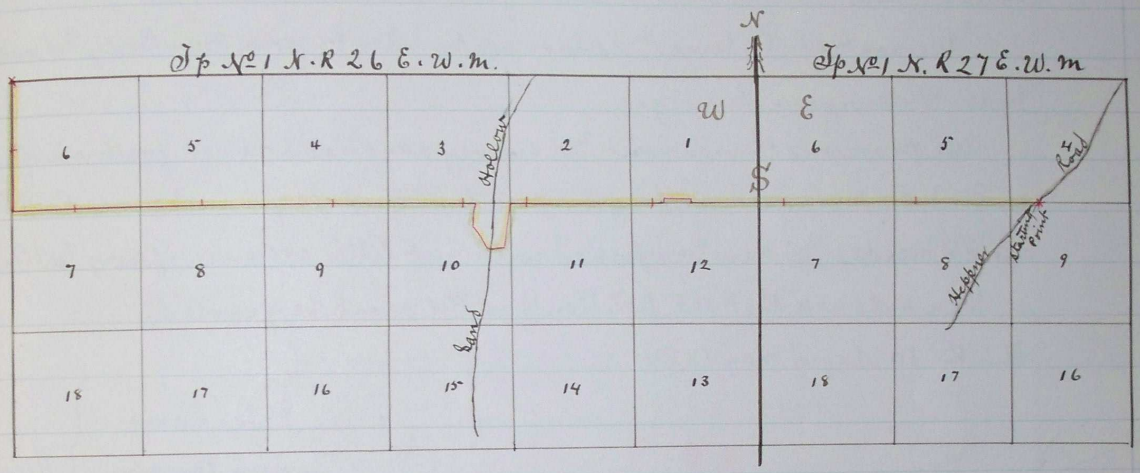

"Scale 1 inch to the mile."

I hereby certify this to be a true plat of Road Survey № 200.
This the 10th day of June 1884

W. W. Cavness

Journal "F" page 378
" "F" " 449
Recorded Aug 19th 1884
J P Bushee
Clerk.