


Plat of Road No 196

Sp 5. N. R 33. E. W. M

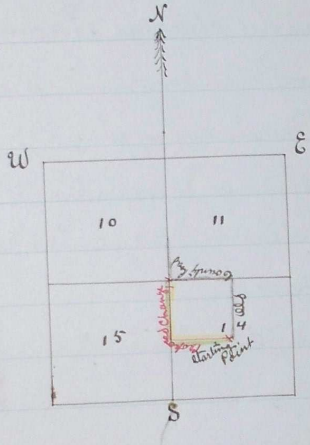

"Scale 1 inch to mile"

Journal "F" page 380
 .. "F" .. 451

I hereby certify this to be
 a true Plat of Road No 196. Surveyed
 May 5th 1884.

By W. W. Caviness.

Recorded Aug 19th 1884

J.P. Swhee
 .. Clerk