


Plat of change in County Road N^o 164

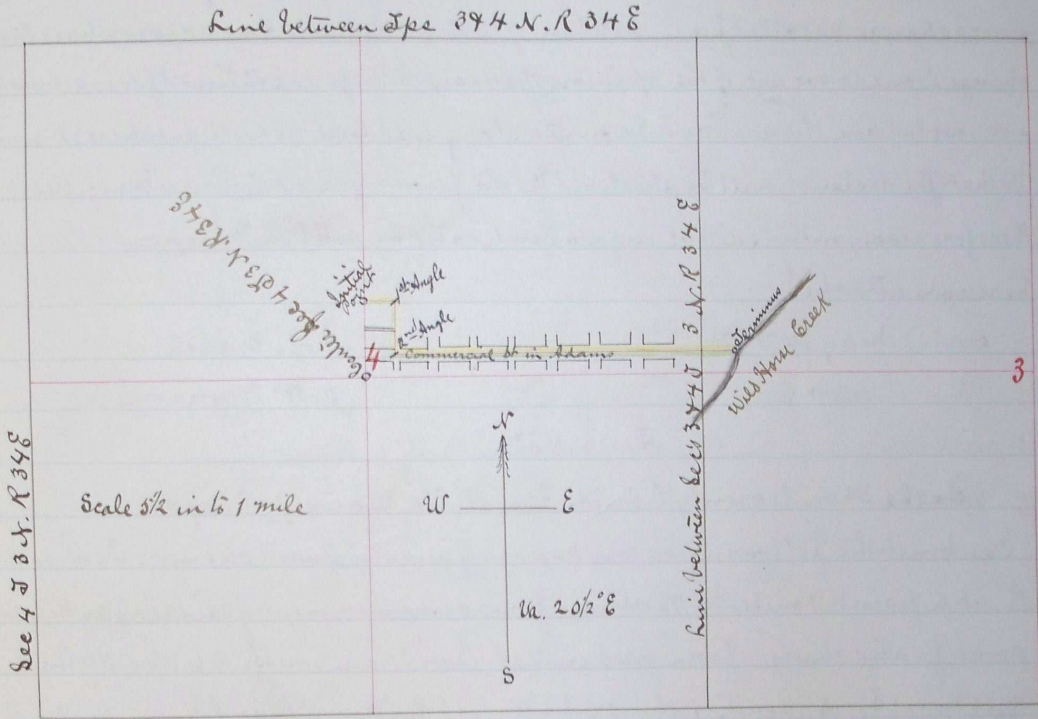

Journal "F" page 426
 " " " " 452

Plat of change in Co Road 164
 as surveyed July 18th 1884

Jno C. Arnold
 Surveyor.

Recorded Aug 20th 1884

J.P. Bushee
 Clerk