


Plat of Road No. 207.

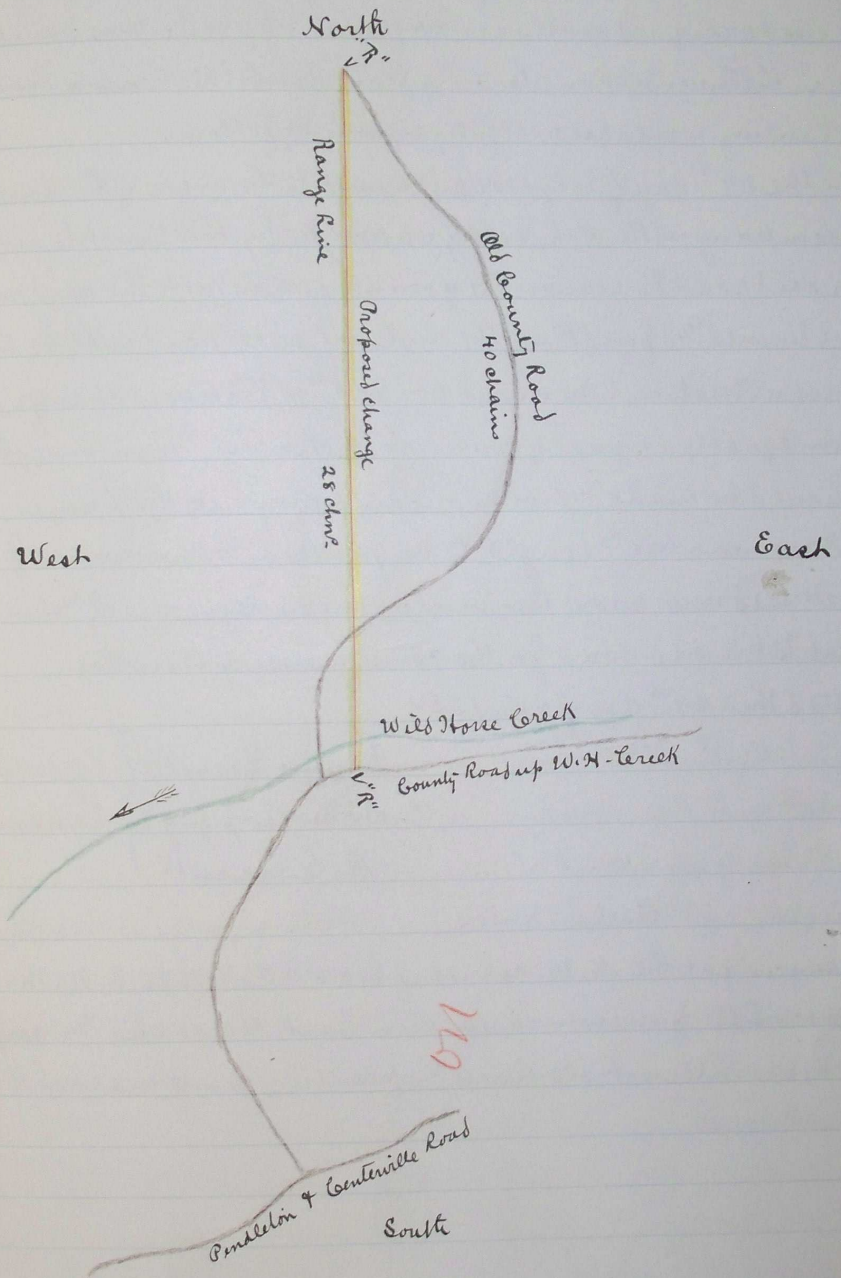

Journal "F" page 403
 " " "F" " 454

Recorded Aug 20th 1884

J.P. Bushee

Clerk