


Plat of Road No 232.

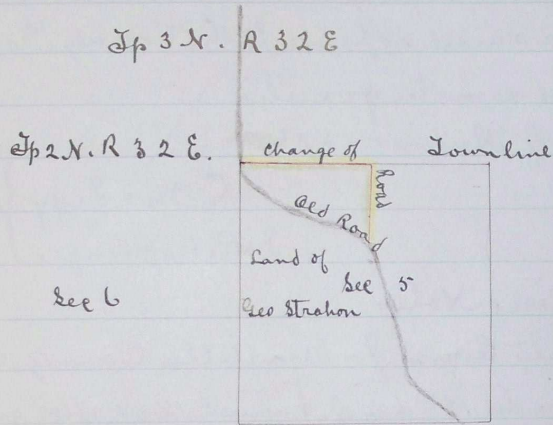

Journal "F" page 428
 " "F" " 451

Recorded Aug 20th 1884

J.P. Bushee

Clerk

I hereby certify that the
 above is a true and correct plat
 and survey of said change of Road
 this 29th day of July 1884

A. L. Coffey

appointed surveyor by
 the order of the County
 Court, Umatilla Co. Oregon.