


Plat of Road No 206.

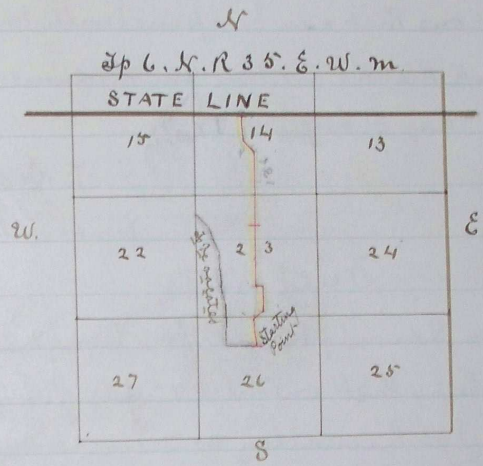

Scale 1 inch to the mile.

Journal F. page 397
 " F " 454
 " F " 578

I hereby certify that this is a true
 plat of Road Survey No 206

W. W. Caviness
 Surveyor.

Recorded Sept 15th 1884

J. P. Bushee
 Clerk.