


Plat of Road No 211.

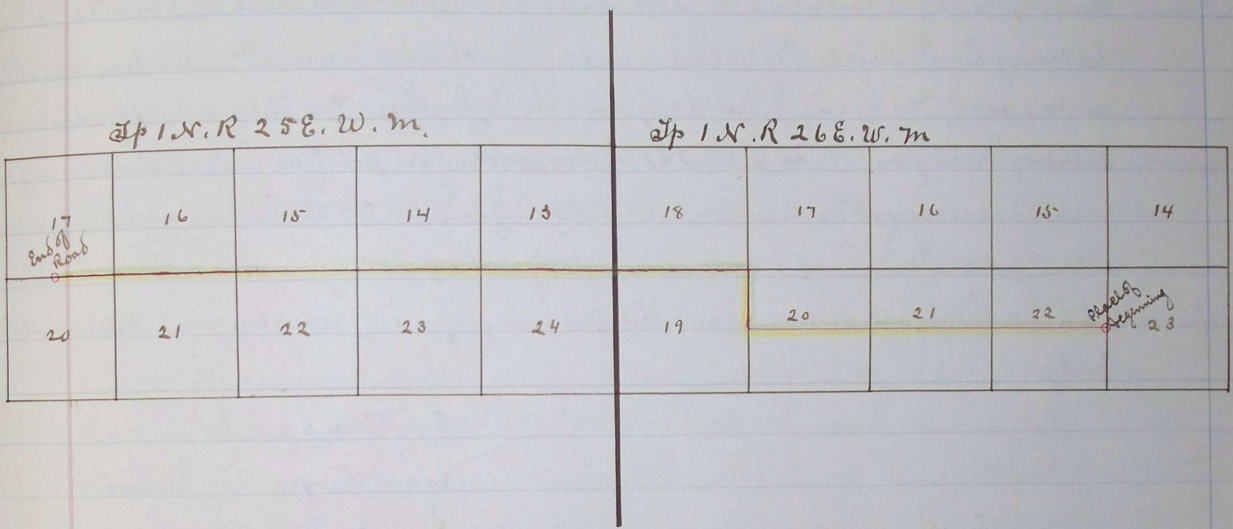

Journal F. page 458

" F. " 572

Recorded Sept 15th 1884

J.P. Busher

Clerk

State of Oregon }
 County of Umatilla }

I hereby certify that the above
 plat and specifications of Road No 211 are true and
 correct, Aug 20th 1884

Julius Keithly
 Deputy County Surveyor.