

7 miles, where I planted a post & marked it according to law, thence in same course dist 19⁵⁰ chains, thence S. 35 1/2° E. dist 10⁵⁰ ch, thence S. 50° E. dist 7⁵⁰ ch, thence S. 22° E. dist 25⁰⁰ ch, thence S 1/2° W. dist 17⁵⁰ ch = 8 miles near to center of Sec 34 Tp 4 S. R 25 E. W. M. point of termination on or near the line between Umatilla & Wasco Counties

State of Oregon }
County of Umatilla }


I hereby certify that the above plat^d specifications of Road No 215 are true and correct.

This 28th of Aug 1884.

Julius Keithly
Deputy County Surveyor

Road No 215.

Tp No 3 South Range 25 E. W. M

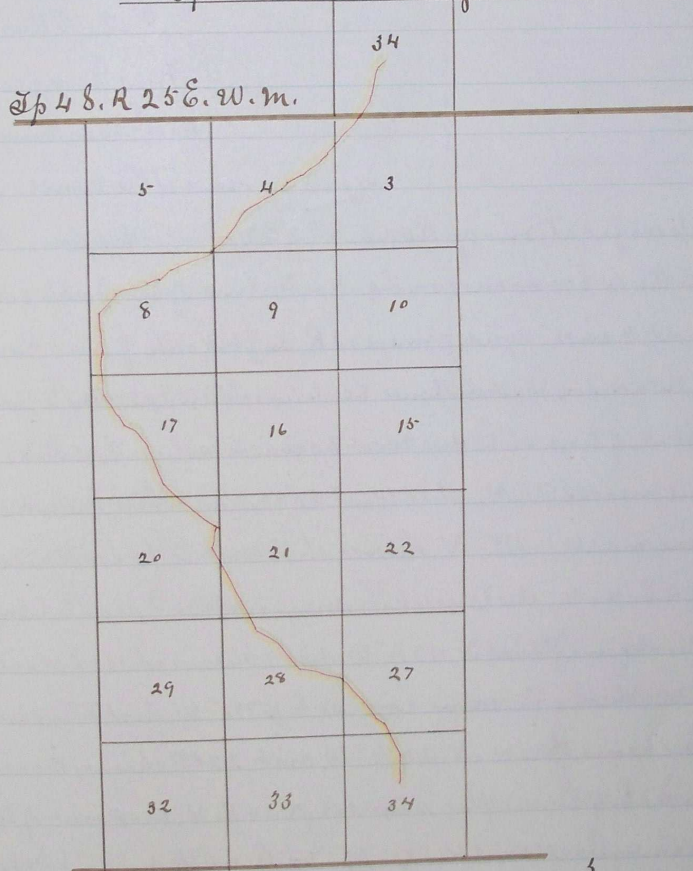

Journal F. page 457

" " " 574

Recorded Sept 16th 1884

J.P. Bush
Clerk.

State of Oregon }
County of Umatilla }

I hereby certify that the above Plat^d specifications of Road No 215 are true and correct.

This 28th of Aug 1884.

Julius Keithly
Deputy County Surveyor