


Plat of Road No 227

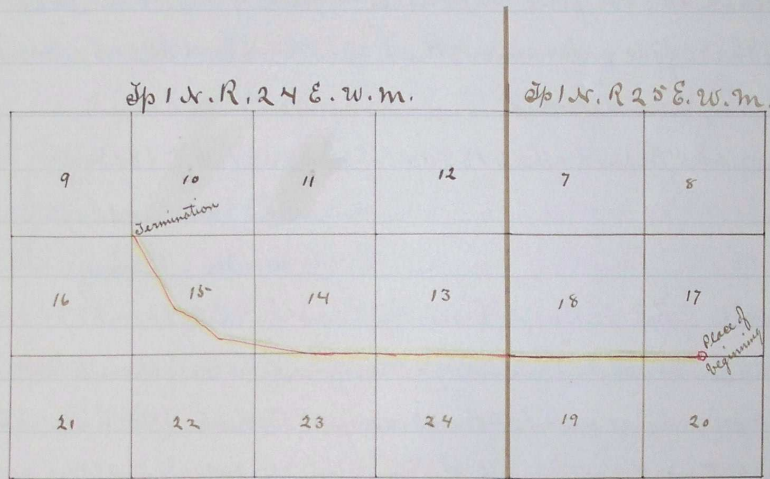

Journal F. page 467

" F. " 575

Recorded Sept 16th 1884

J.P. Bushnell
Clerk

State of Oregon }
County of Umatilla }

I hereby certify that the
above Plat and Specifications of Road No
227 are true and correct.

This 28th Aug 1884

Julius Keithly
Deputy County Surveyor