

chains. Stone Cor. purporting to be center Sec. 13 & 18. R 30 1/2 E. N. 88° 00' E. 8 1/2
 80.00 chains Stone Cor. in mound in angle made by furrows N. & W. set basalt
 stone, marked M.V. about 30 feet N. of R.C. N. 88° 00' E. 22.50 chains intersect
 road leading from Heppner to Pendleton. Course N. 52° E. set basalt stone 8x10x
 18 in. about 30 feet S. W. of R.C. the first two miles of this road runs up a canon
 is considerably rocky, & will require grading in many places.


I hereby certify that the foregoing is a correct copy of the field notes of the
 survey of County Road No. 225. for Umatilla County, Oregon, as surveyed by one
 Aug 19 & 20, 1884.

Jno C. Arnold, Surveyor.

I hereby certify that the following is a correct plat of county road
 No. 225, as surveyed by one Aug 19 & 20, A.D. 1884

Jno C. Arnold, Surv.

Plat of Road No. 225.

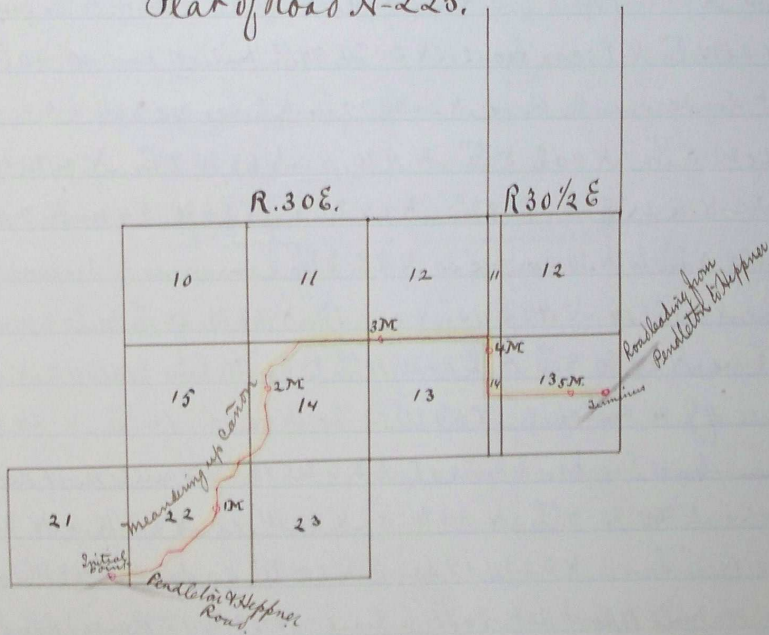

Journal F. page 466.

" F. " 574

Recorded Sept 17 1884

J.P. Bushie
 Clerk