


Plat of Road No 218.

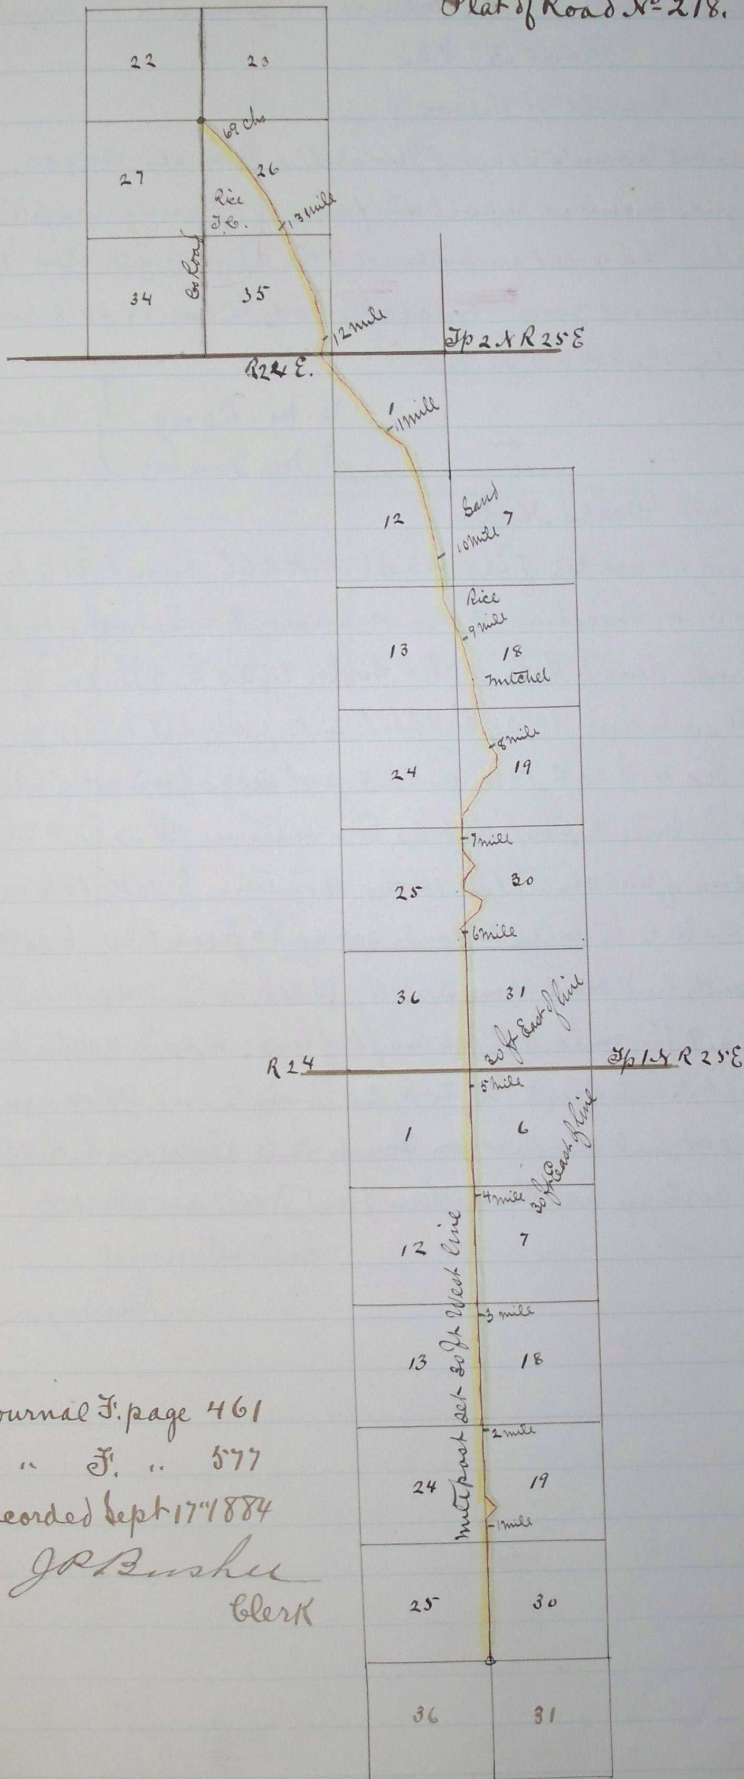

Journal F. page 461

" F. " 577

Recorded Sept 17 1884

J.P. Bushie
Clerk