


Cont. Road N^o 148.

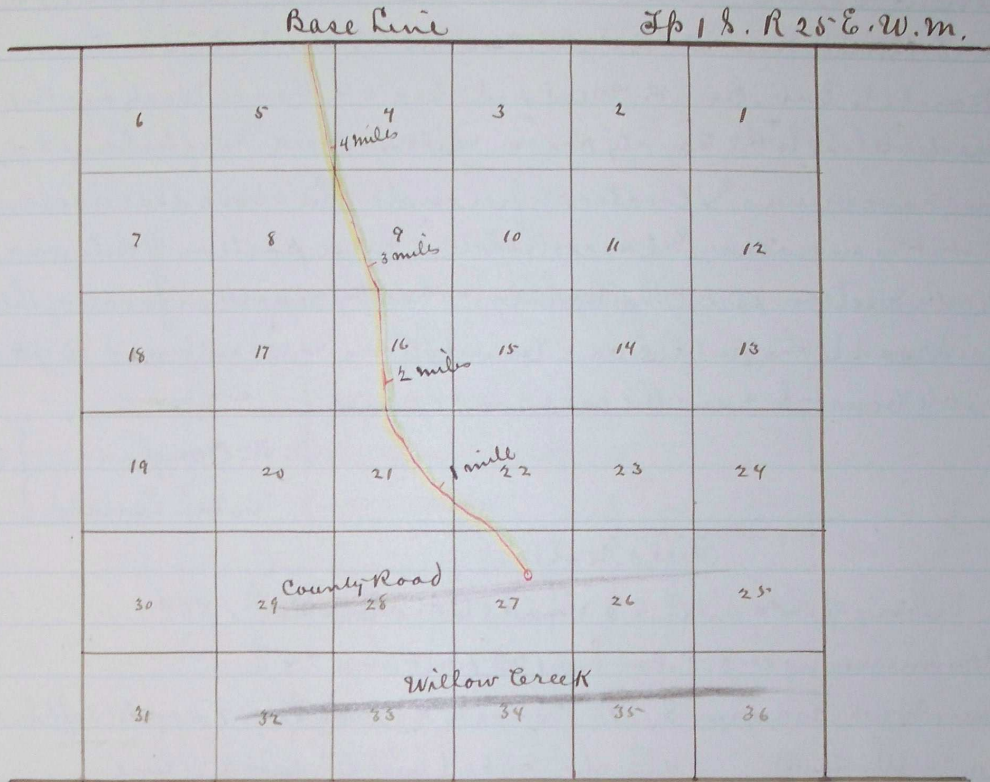

Journal "F" page 510

" " " " " " 681

Recorded Feby 6th 1885

J.P. Bushe

Collector.