


Plat of Road No 233.

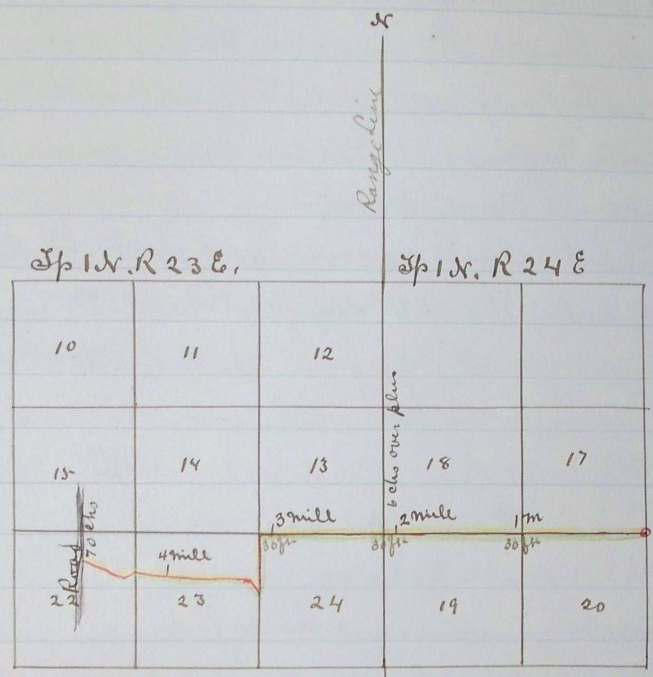

Scale 80 chs to the inch

Journal "F" page 583  
" " " " 683

Recorded Feby 6 " 1883  
J P Bushie  
Clerk