490

ROAD No 241

Road No 241

Report of Vieiwers. Field Notes and Plat of Survey of a County Road Commencing on Sec line at a Road Stake 65 rods S. of Sec corners of Secs 3.4 & 33 & 34 on Tp line between Tps 3 & 4 N. R 31 E. and ending at Co Road in Despain Gulch.

Report of Vieiwers

To the Hon County Court for Umatilla Co. Orgn. Pendleton Or Mch 14th 1885

We the undersigned. having been appointed by your Hon. body to view County Road No 241. for the above named County and State. met at the place and time appointed. and after being duly qualified by W. W. Cavinees. Surveyor, we vieiwed and surveyed said road as set forth in the order.

We find the said road to be a good and practical route, and one that is much needed and would most respectfully ask that the petition for the same be granted.

D. Hodyshell
A. P. Oliver
J. F. Temple
} Vieiwers

Field Notes. Road No 241

To the Hon County Court. Umatilla Co. Oregon.

I hereby certify that on the 14th day of March. 1885. after qualifying D. Hodyshell. J. F. Temple & A. P. Oliver. vieiwers & Ellis Simmons & D. Hodyshell. chairman & A. F. Parker. marker. I proceeded to survey of County Road as set forth in Road No 241 as described in the accompanying field notes.

Beginning at a road stake 65 rods South of Secs 3. 4. 33 & 34. on Tp line bet Tps 3 & 4 N. R 31 E. W. M. Set P. marked R. run S. on line 162 rods: Angle E. 20° S. 15-8 R. Set P. m 1, Angle E. 35° S. 120 R; Angle E. 10° S. 36 R; Angle E 2° S. 38 R. Angle E 21° S. 126 R; Set P m II; thence on same Deg. 56 R. to the ¼ line of Sec 11 Tp 3 N. R 31 E. 57 R. N. of Center of Sec 11. Set P. marked R.

Surveyed March 14th 1885 by

W. W. Cavinees.

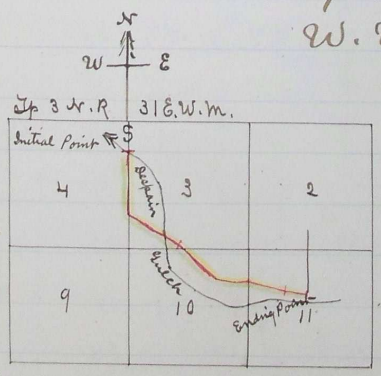

Scale one inch to the mile

Journal F. page 692
" G " 32
Recorded April 28th 1885
J. P. Buskirk
Co Clerk

I hereby certify this to be true plat of Road Survey No 241
Surveyed March 14th 1885
W. W. Cavinees
Surveyor