

ROAD No

Road No 243

243.

Report of Viewers. Field Notes and Plat of Survey of a change in a County Road on the lands of W. M. Scott et al

Report of Viewers

To the Hon Co. Court

We the undersigned being appointed by your Hon Body to view the proposed change in Co Road No 243. We met at time and place appointed and after being duly qualified by W. W. Caviness. Surveyor for said County, we viewed and surveyed said road and the proposed change as set forth in the order, and we find that the proposed change will make no material difference in the distance of said road, the petition is reasonable and said change should be granted. That said road as changed, is now open a legal width and is in all respects equal to the old road for the convenience of travellers.

Dated April 15. 1885.

W. H. Bond } Viewers
W. S. Claypool }
Noah Auspauch }

Field Notes


To the Hon Co Court for Umatilla Co. Ogn

I hereby certify that on the 15. day of April 1885. after qualifying Harry Bond, Wm Claypool & Noah Ashpaugh viewers and as chainmen I proceeded to survey off a change in a County Road for the above named County and State as described in the accompanying field notes.

Beginning at a point where the Co Road crosses the East line of the S E 1/4 of Sec 11 T4 N. R 33 E. Set post marked R. Run North on West side of line bet. Sec 11 & 12. 28 Rods. Angle North 20 deg E 4 Rods. Angle N 20 deg W 4 R. thence North on West side of line 50 Rods to the 1/2 mile corner of Sec 11. thence West 28 Rods bordering on 1/2 mile line on south side, Angle West 20 deg North 6 Rods. Angle West 20 South 6 Rods, thence West 10 Rods bordering on line on South side set Post marked R. Intersecting Co Road at this point.

Surveyed April 15. 1885 by W. W. Caviness.

T. 4 N. R 33 E. W. M.

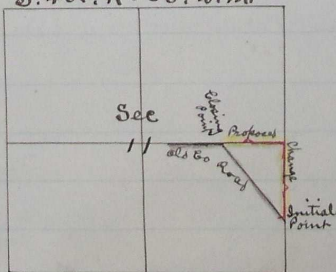

Journal G, page 19
' ' G ' ' 44
Recorded April 28/1885
J P Busher
Clerk

I hereby certify this to be a true Plat of Road Survey No 243, Surveyed April the 15. 1885 by W. W. Caviness

Scale 1 inch to the mile