

ROAD NO

Road No 247

247.

Report of Viewers. Field Notes^Q Plat of Survey of a Co Road commencing 80 Rods N. from S.W. cor of Sec 23 Tp 6 N. R 35 E^Q intersecting Co Road at a point 80 rods N of S.E. cor of S.W. 1/4 Sec 24.

Report of Viewers

To the Honorable Co Court

We the undersigned being appointed by your Honorable body, to view a proposed Co Road No 247.

We met at time^Q place appointed by you^Q after being duly qualified by W.W. Caviness, Surveyor, we proceeded to view said Road as set forth in the order we find the proposed Road to be a good & practicable route for a County Road^Q one that is much needed, we would ask that the petition for the same be granted, this the 8th day May 1883.

U. Garred }
A.M. Eelam } Viewers.
W.T. Wright }

Field Notes. Road No 247.


I proceeded to survey said Road as directed by the Order Reg. at the Co. Road at a point 80 rods North of the South West corner of the South East quarter of Sec 23 Tp 6 N. R 35 E. W. m. set post marked R. thence running East through the land of O.R. Ballou^Q through the land of W.J. Goodwin^Q on the line bet. Richard Brenehley^Q & W^m Semple^Q on line bet. Oscar Hesse^Q & Richard Brenehley^Q on line bet. Richard Brenehley^Q & D. M. Johns intersecting Co Road 80 Rods North of the S.E. cor of S.W. quarter of Sec 24 Tp 6 N. R 35 E. W. m set post miles one. Said Road to be 40 feet wide.

Surveyed May 8th 1883

By W.W. Caviness

Plat of Road No 247.

Tp 6 N. R 35 E. W. m

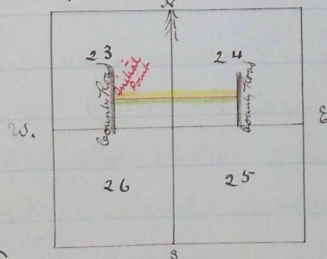

Journal G. page 39

" G. " 774

Scale 1 inch to mile

Recorded July 18th 1883

J.P. Bushen
County Clerk

I hereby certify this to be a true plat of Road No 247

Surveyed May the 8th 1883

By W.W. Caviness