Plat of Road No 237

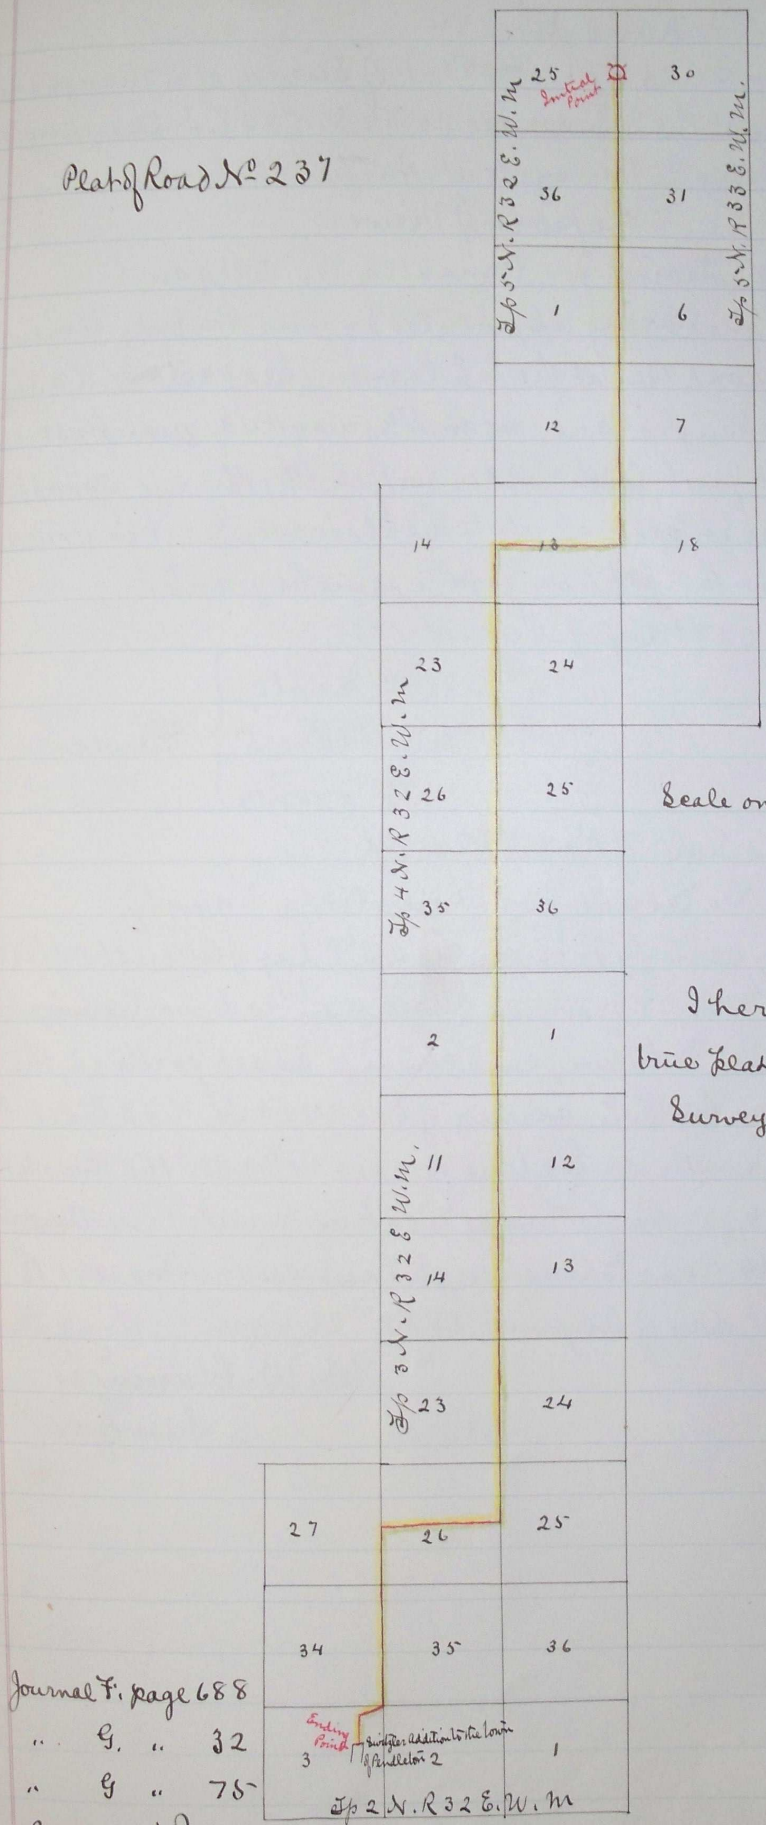

Scale one inch to the mile

I hereby certify this to be a true Plat of Road Survey, No 237. Surveyed March 4th 1883.

W. W. Cravines
Surveyor.

Journal F. page 688
" G. " 32
" G " 75

Recorded July 21st 1880

J. P. Bushee
Co. Clerk.