


Plat of Road No 271.

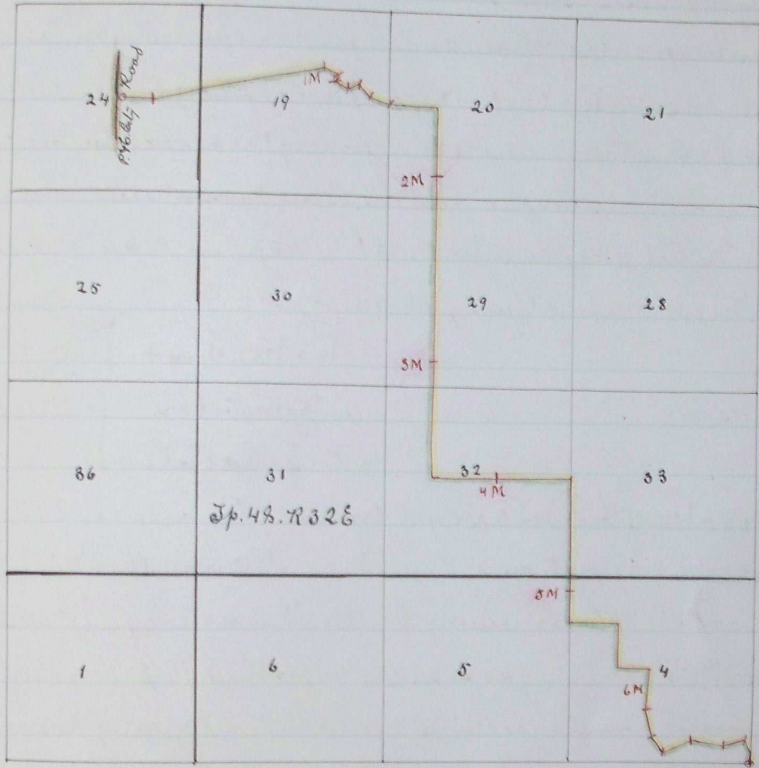

I hereby certify this to be a true  
plat of County Road No 271. Umatilla Co., Or.

Jno. C. Arnolds, Surveyor

Book 9, page 348

.. 9. .. 402

Recorded Sept 23<sup>rd</sup> 1886

C. A. Hartman

County Clerk.