

24

ROAD NO
268

Road No 268.

Report of Viewers, Field Notes and Plat of Survey, of a change in County Road on the land of Ira J. Crofut.

Report of Viewers

To the Hon. County Court for Umatilla Co., Or.

We the undersigned viewers in change in County road petitioned for by Ira Crofut would hereby recommend that said change be granted.

S. M. Zimmerman
Charles H. Campbell

Field Notes of the survey in change in South Cold Spring Road 268.

Aug 17th 1886.

Met S. M. Zimmerman and Char. H. Campbell viewers, at time and place appointed and taking E. Zimmerman and Adolph Eggerth as chainbearers and Geo. Gibson as marker, who were each qualified as required by law, I commence at point on old South Cold Spring Road as pointed out by the viewers, and find the same to be 22.50 ch N. W. from 16 m. post on said Cold Spring Road and 14.75 ch from 1/4 Sec. cor. bet. Secs 23 & 24 T. 4 N. R. 31 E. Eastward through center said Sec.

I run thence on magnetic Courses


- N 77° 45' W 10.00 chs Set angle stake N. of Mr. Crofut's Res.
- N 50° 10' W 33.07 Set post for terminus at intersection old road course N. W.

All the posts used are of the size and are marked and mounded as required by law.

Jno. C. Arnold Co. Surveyor
Umatilla Co., Or.

Plat of Road No 268

T. 4 N. R. 31 E.

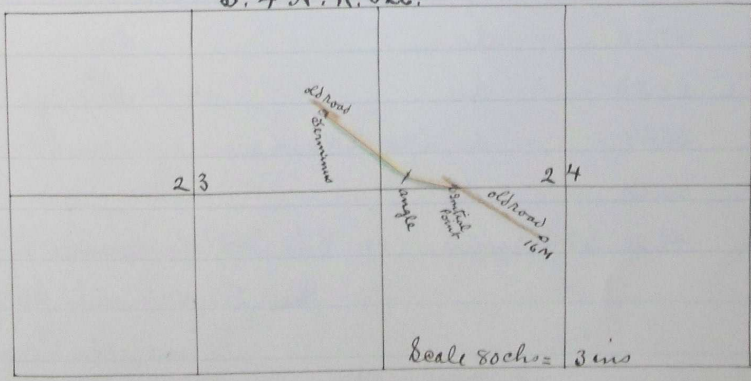

Book 9, page 342

" 9, " 399

Recorded Oct 25th 1886

J. A. Hartman Co. Clerk

I hereby certify this to be a true plat of Road Survey, 268.

Jno. C. Arnold
Surveyor