


Plat of County Road No. 288
Umatilla Co., Oregon

Township No. 3 N. Range 30 E. W. M.

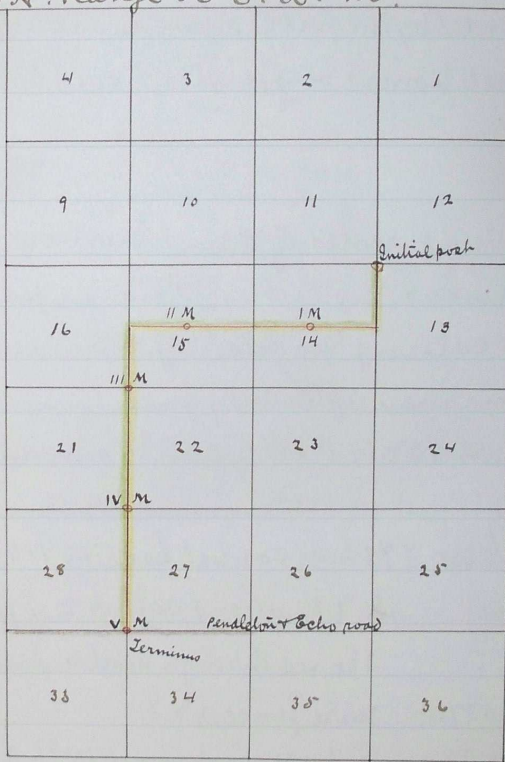

Journal G, page 525

" G " 587

Recorded Aug 5th 1887

G. A. Hartman

Clerk

By J. H. Parkes, Deputy.

I hereby certify the foregoing to
be a correct plat of the survey of
Road No. 288.

Jno C. Arnold, Co. Surv.

Vault Box No. 279