


around it for terminus.  
 I hereby certify the foregoing to be the correct  
 Field Notes of the survey of Road 298 for Umatilla County, Oregon  
 Jno C. Arnold,  
 Surveyor

Plat of County Road No 298.

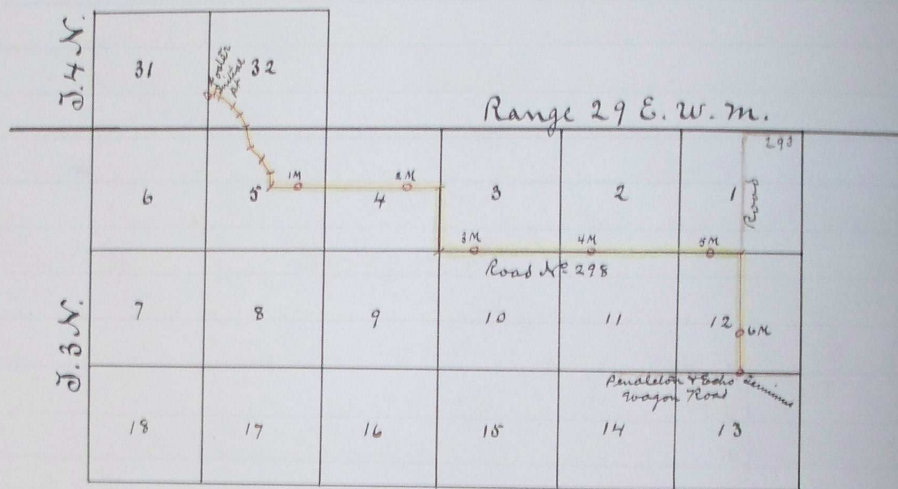

I hereby certify the foregoing to be a  
 correct plat of County Road No 298.  
 Jno C. Arnold,  
 Survr.

Journal G. Page 5884  
 " " " 631  
 Road Granted Sept 26" 1887  
 Recorded Jan 17" 1888  
 G. A. Hartman  
 Clerk  
 By J. H. Parker  
 Deputy