

and Wm McDannald's house bears S 84° W, about 20 chains

I move temp. to S. cor. on W. 1/2 of N. bndy. of said Sec. 17, East 16 links and on true line bet. said mile posts, set round boulder, 13 inches long and 6 inches in diam, marked with a cross on top end.

To perpetuate cor. for said sees, 16 & 17, I set, at true point as before described, a basalt stone 12 x 6 x 8 ins marked with a cross on top end.

I set initial road post in mound 30 links N. of 1/2 S corner on E 1/2 of line bet. said sees 17 & 20 in T 6 N. R 35 E. W. M. and run, thence on true line bet. said sees, 40.03 chs to 1/2 S. cor. on W. 1/2 of said line bet. sees. 17 & 20. Set angle stake at true point and turn thence South, on line bet. Wm A. Wells and Wm McDannald, 80.00 chs set 1 mile post 30 links west of true line. 12.22 chs to S. cor. on N. bndy. of Sec. 17, State line. Set angle stake at true point, and turn, thence West along State line. 16.73 chs 24" mile post on N. bndy. of St. of Oregon set terminus, post in mound 40 links south of true point.


Tuesd Mch 27" '88

I hereby certify the foregoing Field Notes of Road Survey No 307 are correct.

Jno C. Arnold, Suror. U. Co. Or.

Plat of Road No 307.

T 6 N. R 35 E. W. M.

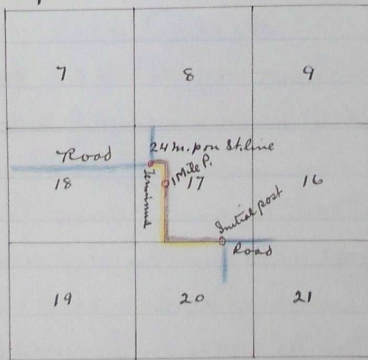

I hereby certify the foregoing to be a correct plat of road survey No 307 U. Co Or.

Jno C. Arnold
Suror U. Co. Or.

Book 9. page 729

" H " 14

Road Granted April 12" 1888

Recorded Apl 18" 1888

G. A. Hartman

Clerk

By J. H. Parker

Deputy