


327, for Umatilla County, Oregon, are correct.

Jno. C. Arnold, Surveyor

Filed July 1<sup>st</sup> 1889 }  
G.A. Hartman, Clerk.  
42.

ROAD  
33

Tp. 3 N. R. 29 E. W. 1.

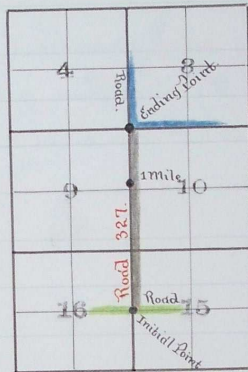

I hereby certify that the foregoing is a true plat  
of Road Survey No. 327 for Umatilla Co. Oregon.

Jno. C. Arnold  
Surveyor.

Filed July 1<sup>st</sup> 1889 }  
G.A. Hartman, Clerk.  
42.