

- 2680 Ravine runs S
- 3400 " " SW.
- 5280 Set 1 m.P. 20' South of line
- 110' Cross fence and enter lane E. & W.
- 1550 Ravine D.E. ascend in lane
- 2700 Summit
- 3015 Lane runs S
- 3150 Ravine SW.
- 4100 Summit
- 5280 Set 2 m.P. 20' South of line: cut 1 on this post and
- 136' turn across the D.E. cor of the SW 1/4 of Sec 30
- 570' Set terminus 20' West of line. Intersect road CR + D.E.

CR 340.20' E
North



Jno Arnold Surveyor.

Filed July 9th 1890
W.M. Pierce Clerk
By R.P. Davis Deputy

I hereby certify the following to be a correct plat of the survey of Road 340 Township 5 N Range 33 E East of Willamette Meridian as made by me June 24th 1890

Jno C. Arnold

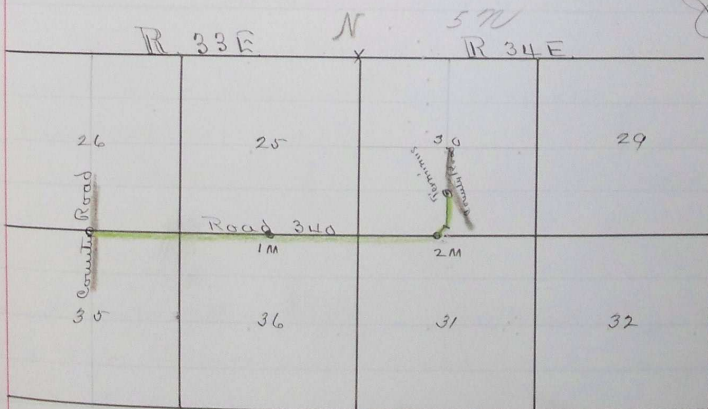

July 16 1890 H 5757