


I hereby certify the following to be a correct plot of Road survey No 330 Township 4 N Range 36 East of Willamette Meridian as made by me on the 28-9 day of April 1890

Jno. L. Arnold

~ Road No 330 ~
4 N 36

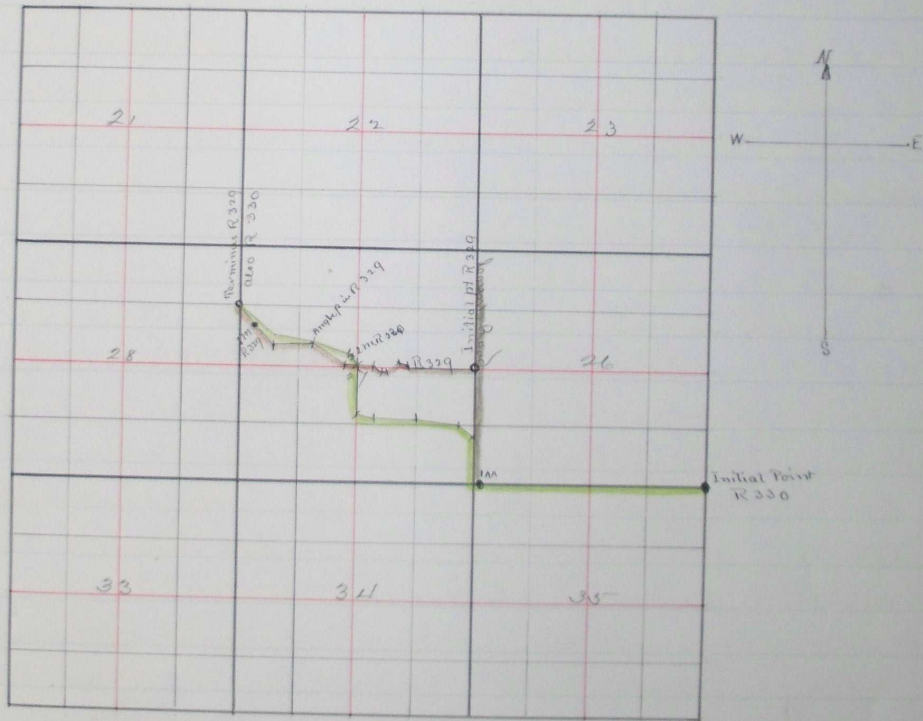

Filed May 8-1890 }
G.A. Harlan Clerk }
Geo. R. Rosenberg Deputy }

July 17 1890 N 581