


ROAD No  
346.

Plat of County Road No 300.

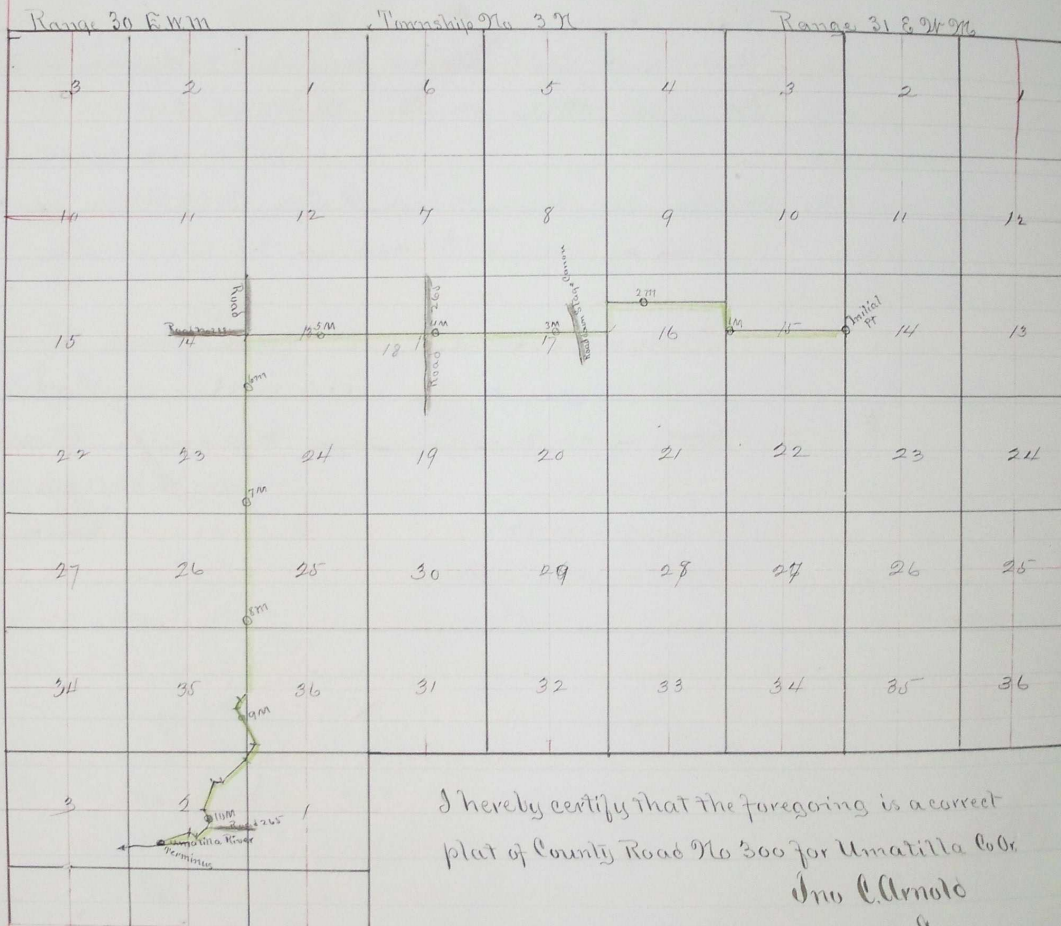

I hereby certify that the foregoing is a correct  
plat of County Road No 300 for Umatilla Co Or  
Jno C Arnold  
Surveyor

Filed Sept 1887  
G. H. Hartman  
Clerk

Sept 1890 Pl 596

Re  
of  
of  
800  
one  
con  
the  
said  
pro  
bef  
to  
  
So  
of  
  
vie  
to 3  
orde  
Sur  
11" 18  
and  
poi  
W  
  
who  
vie  
thre  
I  
sho  
the  
prese  
D  
will  
the  
NR  
W