


I hereby Certify the following to be a correct plat of the survey of Road 328 Township 5 N. Range 33 East of Willamette Meridian as made by me June 19th 1889

Jno C Arnold


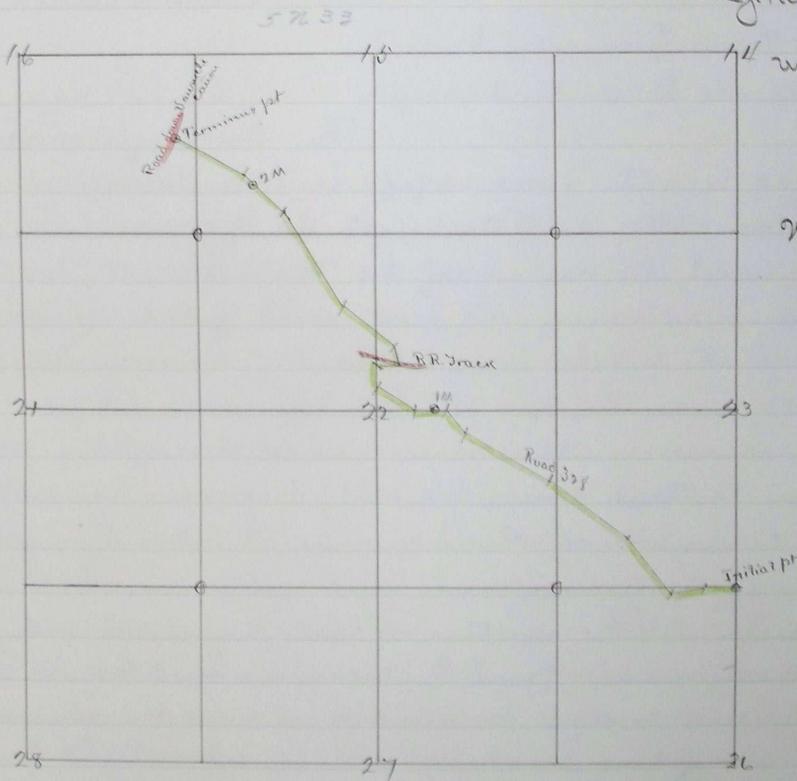

Filed July 3 - 1889 }
by A. Martin and Clerk
by Geo. P. Rosenberg Deputy

Sept 8 1890 # 576