

- 2840 Cross name
- 4900 " "
- 5280 Set 1 m.p. 30 feet South of line
- 6350 Cross name
- 8350 " "
- 10200 " "
- 10560 Set 2 m.p. 30 feet N of line
- 11660 Cross name, Set terminal post at County road running from Holis to Sansyle road.

ROAD No  
343.


I hereby certify that the foregoing field notes of the No 358 road survey are correct.

J. H. Lawry Surveyor

Filed May 5<sup>th</sup> 1891  
W. M. Pierce Clerk

I hereby certify that the following is a correct plat of the No 358 Road Survey as made by me Thursday April 2<sup>nd</sup> 1891

J. H. Lawry  
Surveyor.

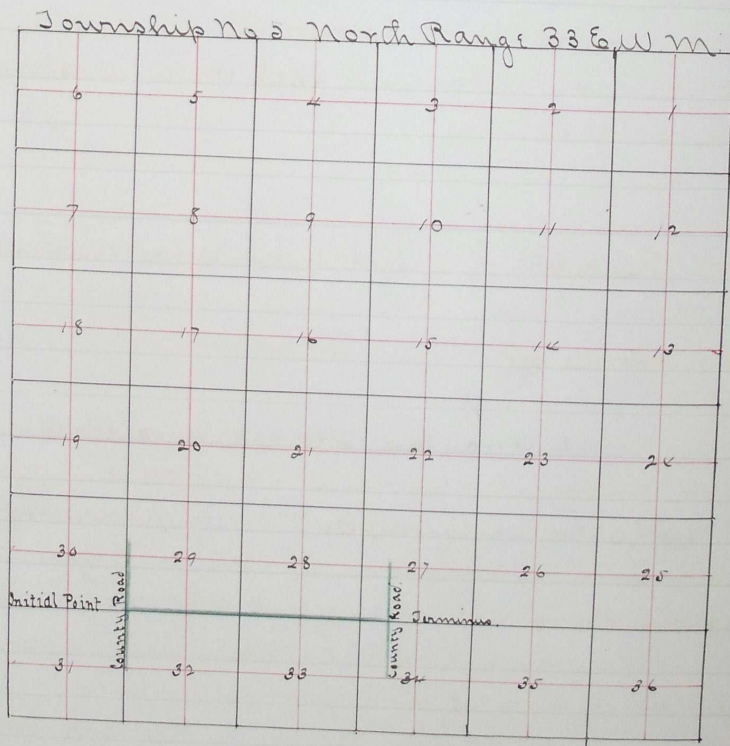

Filed May 5<sup>th</sup> 1891  
W. M. Pierce Clerk

Mar 9 1891 H 715-730