


uld  
lared a

23.

Weston  
road  
vers to  
a duly  
of the  
ction/6  
me line

Track

I set  
nds as  
field  
on,  
wayor  
regon.

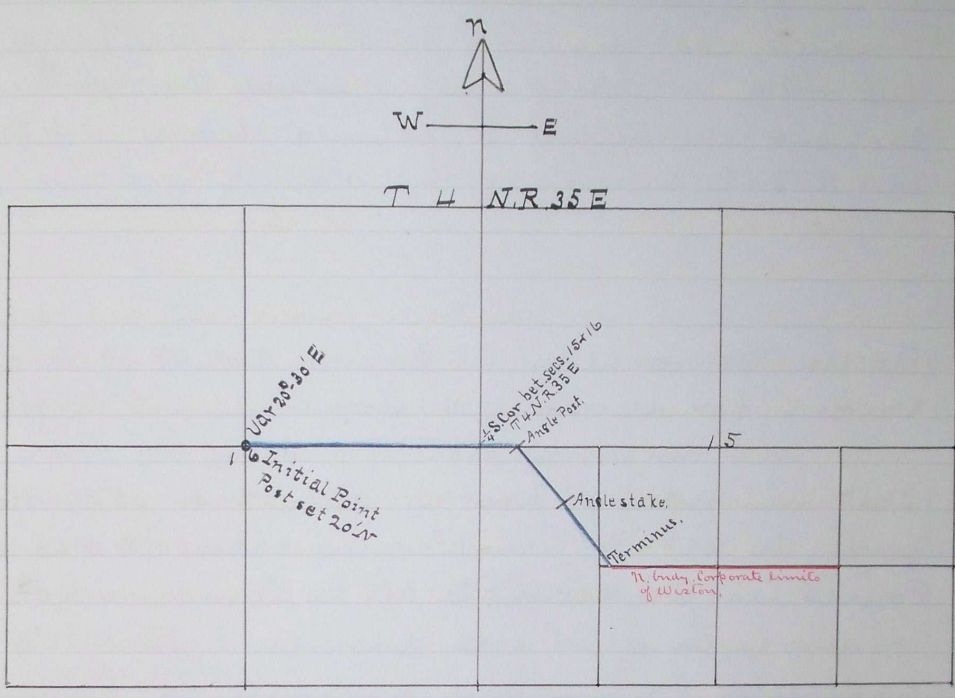

I hereby certify that the foregoing is a true plat of road survey no 343, for Umatilla County, Oregon.

Jno. C Arnold Surveyor  
Umatilla Co. Oregon

Filed Aug 20 1890  
W. M. Pierce Clerk

Nov 6 1890 19 609