

Field notes of the No. 354 road survey, Umatilla Co. Oregon.

I met full board of viewers at Weston June 22 1891, we called to our aid R. M. Powers and Edward Keeney to act as chairman and markers each of whom was duly qualified as directed by law. I set initial post at a point directly opposite the residence of Mr. J. M. Phillips and ran S 79 E,

700 Set angle stake, angle S 43 E

750 Cross Creek

875 " "

1075 " "


1275 " "

1400 Set terminal post on north side of road where north South line between Sec 11 + 12 T₂₀N R 35E, crosses County Road.

I hereby certify that the foregoing field notes of the No 354 road survey are correct.

Filed July 8th 1891
W. M. Pierce Clerk

J. McCawray
Surveyor,

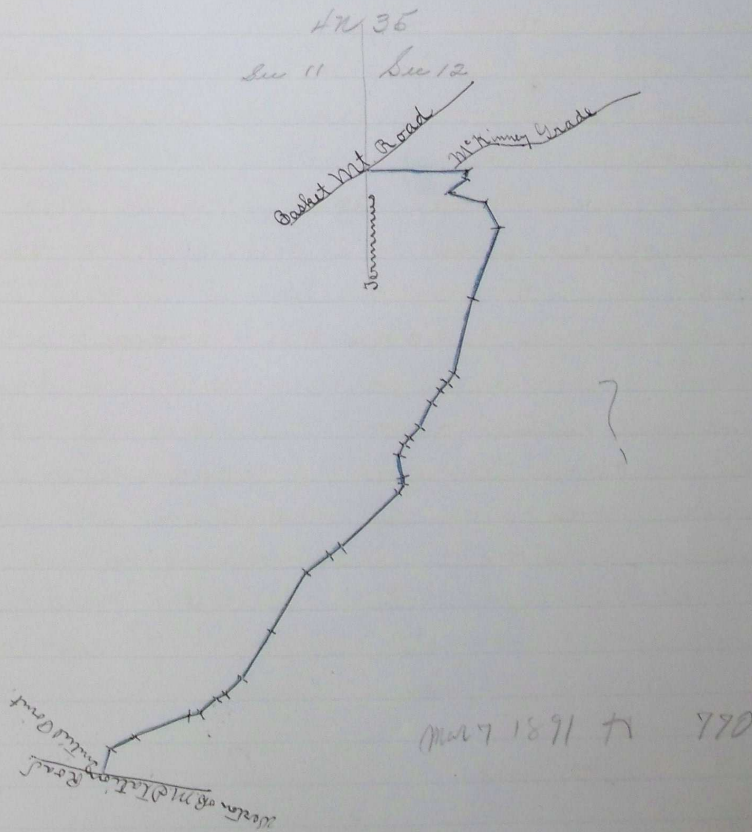

Filed July 8th 1891
W. M. Pierce Clerk.