


Oregon
place
and
kers
y law-
as North

I hereby certify that the following is a correct plat of
the No 360 road survey as made by me June 24 1891

J. H. Lawrey
Surveyor.

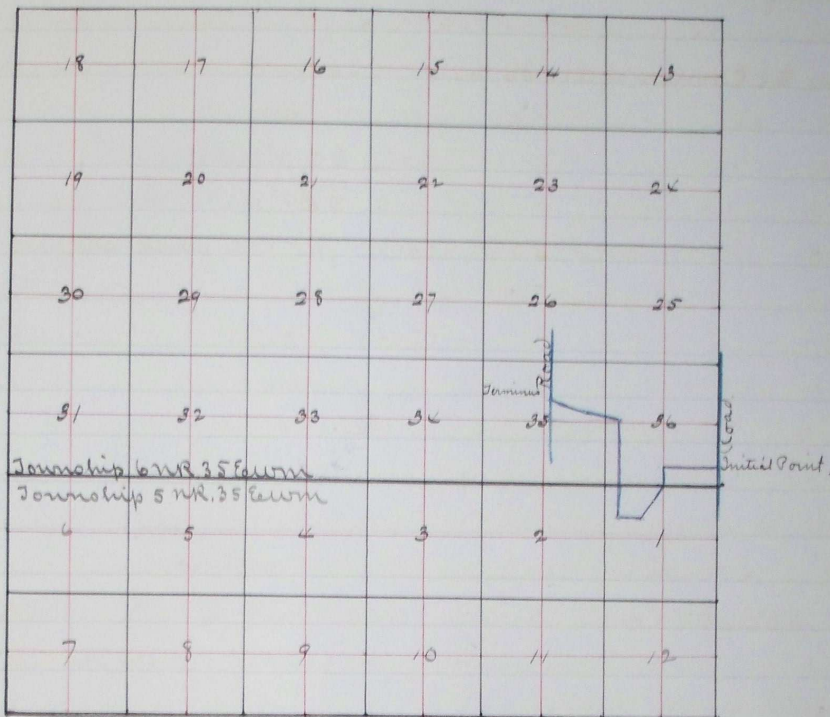

d.

otes of

Filed July 8th 1891

W. M. Sierce Clerk

July 7th 1891 H 725-770