


Plat of Survey Road 292. for Umatilla Co. Oregon

ROAD NO
361.

Township No 1 N Range 32 E Wm

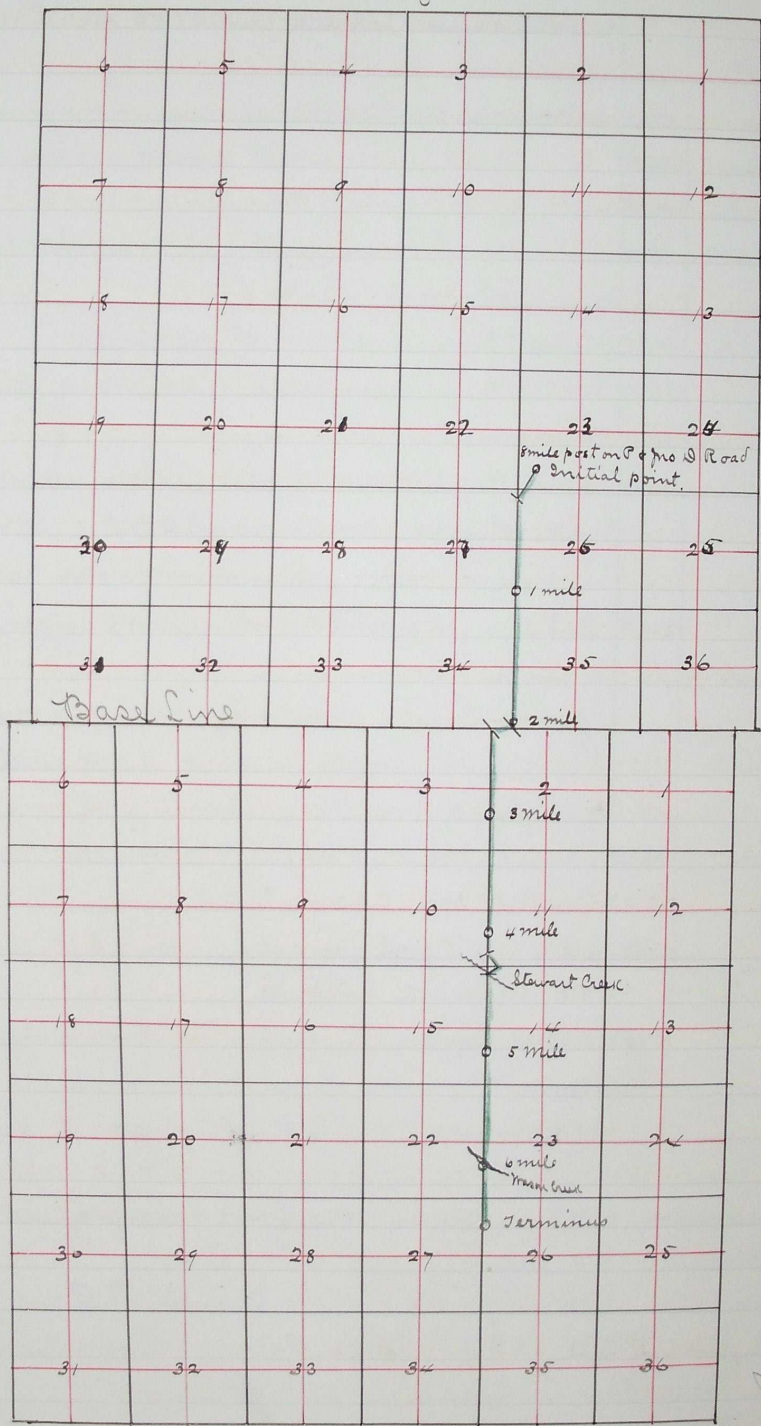

I hereby certify the foregoing to be a correct plat of Road
Survey No 292 for Umatilla Co. Oregon.

Jno. C. Arnold
County Oregon

Filed June 30th 1887
G. A. Hartman Clerk