


Plat of Road Survey No. 365

Township 5 N Range 35 E W.M.

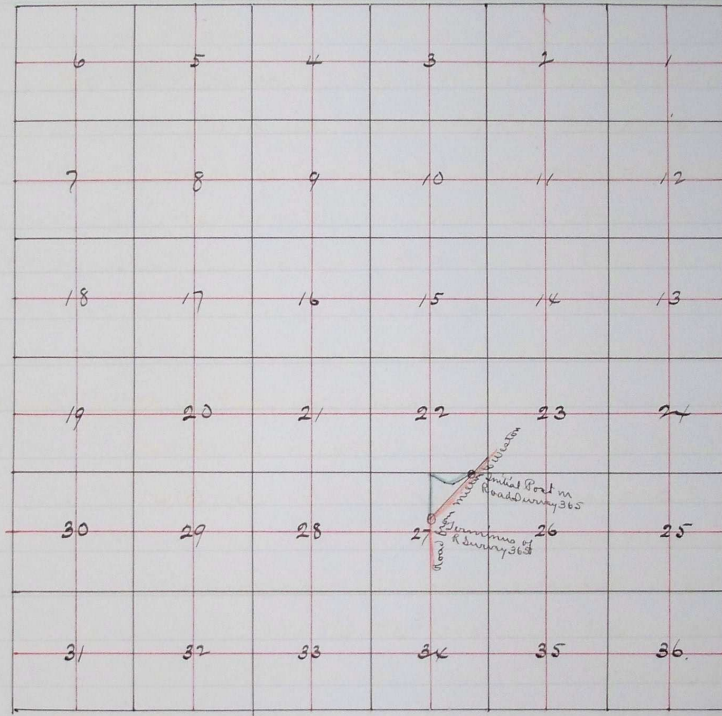

I hereby certify that the foregoing is an accurate plat  
of Road Survey No. 365 for Umatilla Co. Oreg.  
Filed Sept. 8<sup>th</sup> 1891. Jno. C. Arnold  
W. M. Purcell Clerk. Co. Comm.

#763