

State of Oregon
Road Survey

and
Wednesday
road

W. H. ...
required
on the
ground.

and for ...
and
1/2 ft base
the side

run

road,
d for
raised
around the
at

field notes


ed
er,

Plat of Road No 387.

I hereby certify that the following is a correct plat of Road Survey No 387

Jno L. Arnold Surveyor.

T 6. N 35 E. W 4

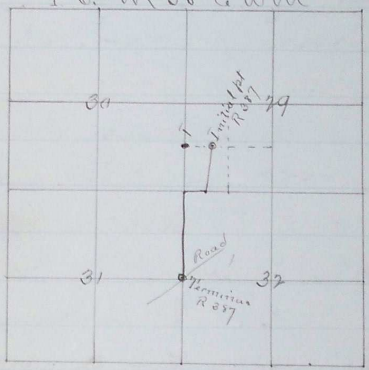

Scale 1 1/2 ins = 30 chs

Filed Apr 22nd 1892 }
W.M.P. were taken }

J 247