ROAD No 388.

Plat of Road No 384.

I hereby certify the following to be a correct plat of the survey of Road 384. Township 6 N. Range 35. East of Willamette Meridian, as made by me

Jno. C. Arnold
Surveyor for Umatilla County, Oregon.

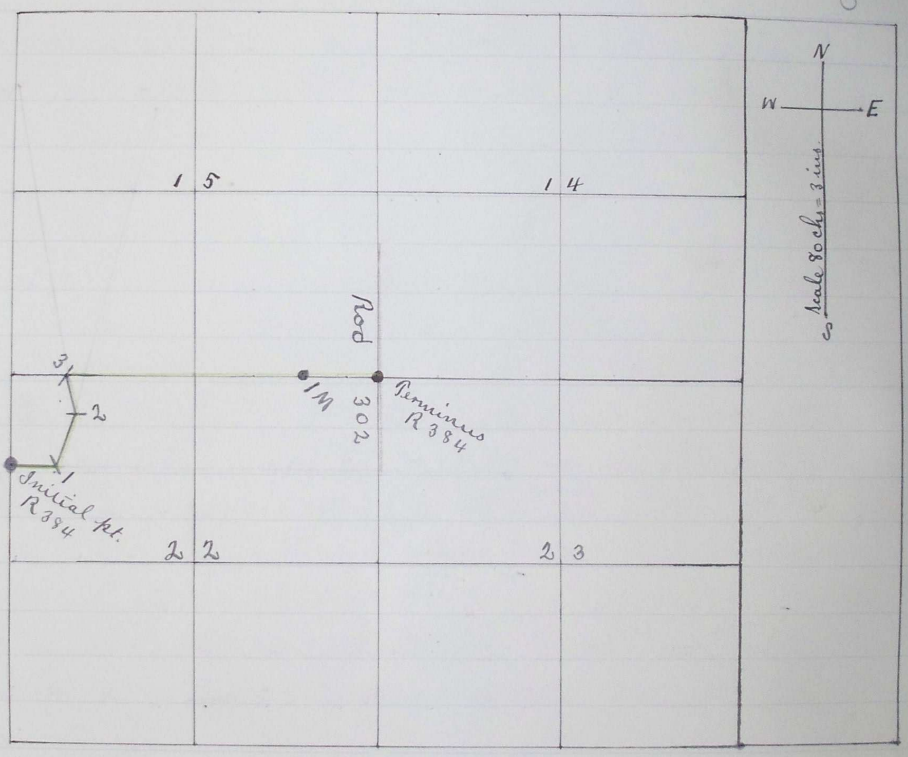

Filed March 12 1892
W M Pierce
Clerk

1232