


# Plat of Road Survey No 389

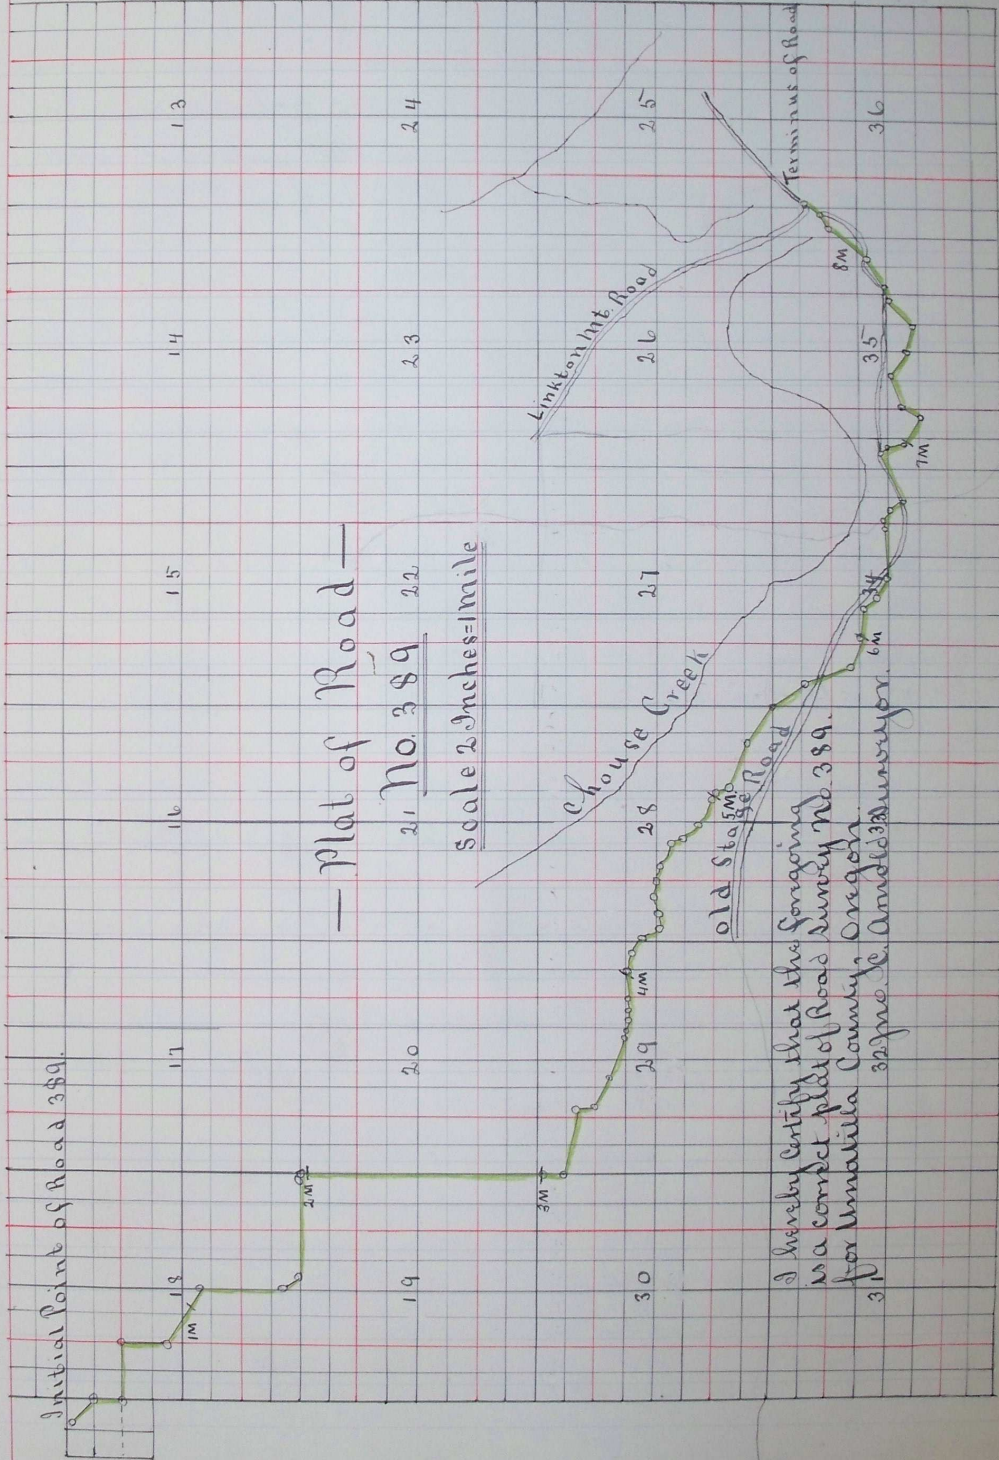

— Plat of Road —

No 389

Scale 2 Inches = 1 mile

I hereby certify that the foregoing is a correct plat of Road Survey No. 389, for Umatilla County, Oregon.

C. Anderson

Filed July 13, 1892  
 W. M. Pierce  
 Clerk

221

366 372 472

line  
 s. of line  
 ascend  
 nit.  
 of line  
 tant,  
 s. W. of line.  
 s. N. " "  
 s. W. " "  
 4' deep  
 (le)  
 W. s. of line.  
 distant.  
 W. East.  
 " "  
 " West.  
 e. mtd  
 rked and  
 defined  
 rest  
 he cor.  
 r Umatilla  
 y Survey.