


# Plat of Road Survey No 412

I hereby certify the following to be a correct plat of the Road Survey No 412 Township 4 N Range 35 East of Willamette Meridian as made by me, Dec. 13<sup>th</sup> 1892

Jno. C. Arnold

Surveyor for Umatilla County Oregon

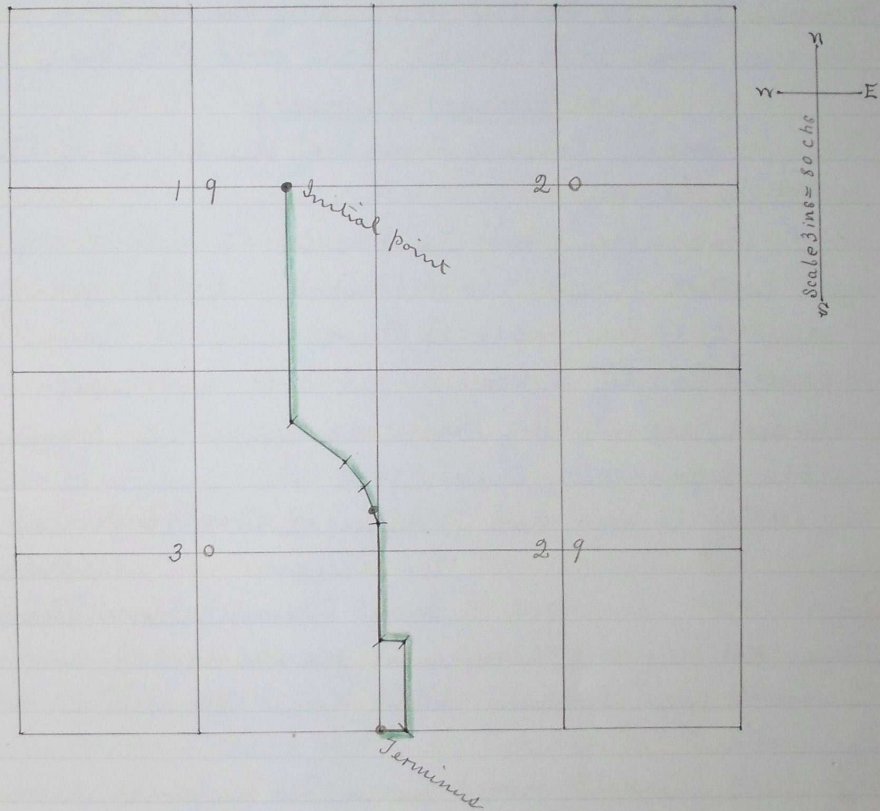

Filed Jan'y 3, 1893  
W. W. Bines  
Clerk

1403

gon

field Views  
De Call H.  
after which  
set by me  
N. Side  
running  
around the  
S. face.  
Course

West.  
Sandy  
un  
ong across  
thru  
around  
s

ascend,  
ong said line

nce,  
said line  
this cor  
shaped  
notch on  
ground  
y No 412  
nds & C.  
iled notes

gon