


Plat of Road No 413

I hereby certify the following to be a correct plat of  
the Road Survey No 413. Township 4 N. Range 32 East of  
Willamette Meridian, as made by me. April 17th, 1893

Jno. C. Arnold  

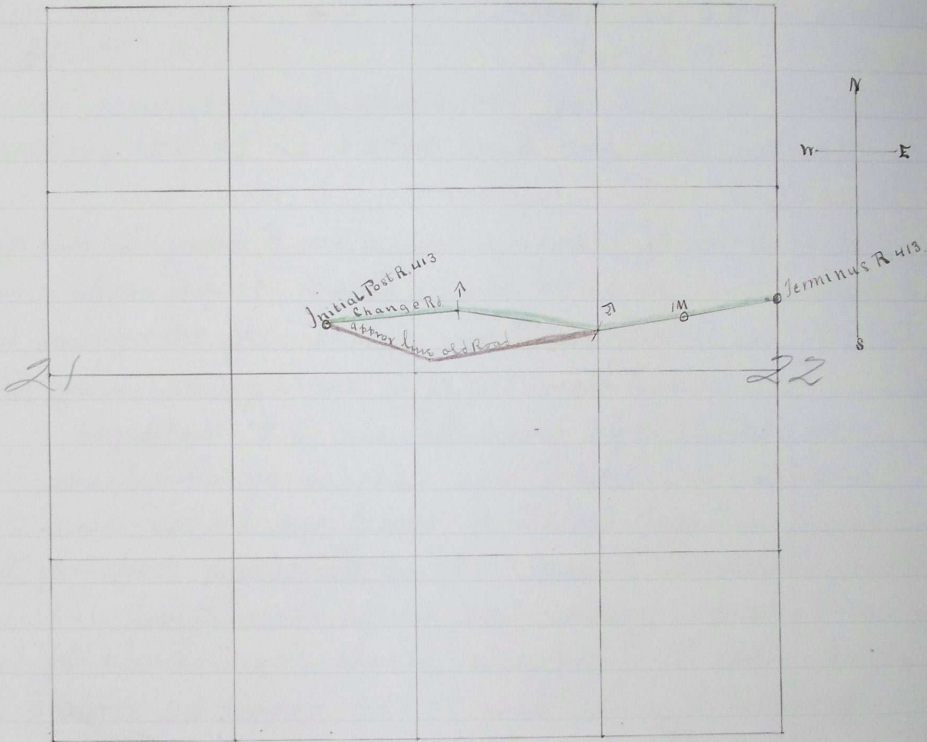

Filed May 3, 1893 }  
W. M. Pierce }  
clerk }

470